

HARRISON
H 2032
10-25-76

MISSISSIPPI
BOARD OF WATER COMMISSIONERS
416 North State Street
Jackson, Mississippi 39201

WATER WELL DRILLERS LOG
COASTAL DRILLING & SERVICE CO.

Harrison

Oct 25 76
date well completed

ROUTE 1 BOX 618

county well located

LANDOWNER: Joe BILOXI, MISS.
Simmons Hardware
Pop Ferry Rd Biloxi
(mailing address)

description of formations encountered	from	to
Top Soil	1	3
Red Clay	3	10
Coarse white Sand	10	45
Down		
Red Clay	45	60
Slits Blue clay	60	110
Coarse Sand	110	140
Soft Blue Clay	140	245
Hard Blue Clay	245	300
fine water sand	300	315
hard Blue Clay	315	440
Rocky	440	442
fine water sand	442	480
Coarse water sand	480	525

WELL LOCATION:
sec. 29 T. 6 N. R. 9 E.
S. W.
Two (2) miles NE of Colony Lake
(distance) (direction) (nearest town)

WELL PURPOSE: Home
(home, irrigation, municipal, industrial)

- WELL COMPLETION DATA:
- (1) diameter (inches) 2"
 - (2) total depth (feet) 525'
 - (3) static water level (feet) 40 below top of ground
 - (4) casing PVC, 515'
(material) (depth)
 - (5) screen 10', 515'
(length) (depth to top)
 - 2", PVC
(size) (material)
 - (6) pump One, 10
(HP) (yield gpm)
 - Ele
(type power)
 - (7) electric log No
(yes or no)

(organization running log)

(8) how well bottom plugged 20'
back with water


DRILLERS REMARKS:

RECEIVED
FEB - 2 1977

MISS. BO. OF WATER COMM

If well telescopes please sketch and show depths.

GROUND LEVEL

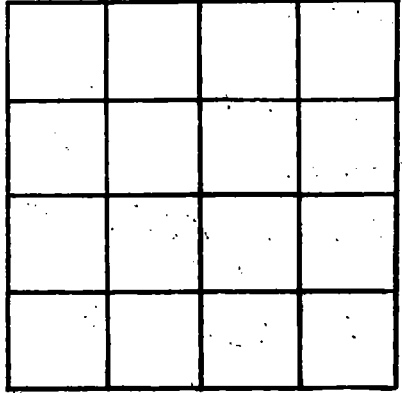

SECTION _____

Please indicate well location X.

ADDITIONAL INFORMATION

If more than one screen, show locations of each on sketch.