

HARRISON
H 2033
12/9/76

MISSISSIPPI
 BOARD OF WATER COMMISSIONERS
 416 North State Street
 Jackson, Mississippi 39201
WATER WELL DRILLERS LOG

Dec. 9 1976 Dunham Well Drilling Harrison
 date well completed firm name county well located

L'ANDOWNER: Billy M. Craig
Nicecrest Rd. Rt. 9 Box 423
Hulfport, Miss.
 (mailing address)

WELL LOCATION:
 sec. 17 T. 6 N. R. 10 E.
 (S) (W)
four miles N.W. of Belzoni
 (distance) (direction) (nearest town)

WELL PURPOSE: Home
 (home, irrigation, municipal, industrial)

WELL COMPLETION DATA:

(1) diameter (inches) 2"

(2) total depth (feet) 305'

(3) static water level (feet) 10' ^{below} above top of ground.

(4) casing PVC, 295'
 (material) (depth)
 (size) If telescope see back.

(5) screen 10", 295'
 (length) (depth to top)
2", stainless steel
 (size) (material)

(6) pump 1, 14 gal.
 (HP) (yield gpm)
electric
 (type power)

(7) electric log _____
 (yes or no)
 (organization running log)

(8) how well bottom plugged Sand Shark


description of formations encountered	depth	
	from	to
top soil	0	30
sand	30	70
gravel	70	85
clay	85	140
sandy	140	180
gravel	180	190
blue clay	190	252
fine sand	252	273
course sand	273	305

DRILLERS REMARKS:

RECEIVED
 JAN 3 1977

If well telescopes please sketch and show depths.

GROUND LEVEL

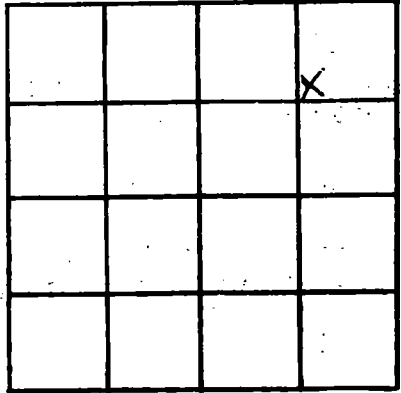

SECTION 17

Please indicate well location X.

ADDITIONAL INFORMATION

If more than one screen, show locations of each on sketch.