

HARRISON
H 234
12/15/76

MISSISSIPPI
BOARD OF WATER COMMISSIONERS
416 North State Street
Jackson, Mississippi 39201

WATER WELL DRILLERS LOG
COASTAL DRILLING & SERVICE CO.

12/15/76 19 date well completed
ROUTE 1 BOX 618 firm name
Harrison county well located
BILOXI, MISS. 39532

LANDOWNER Joe Jordan
Rt 1 Box 640A
Biloxi, Miss
(mailing address)

description of formations encountered	from	to
top soil	1	3
white sand	3	20
soft blue clay	20	35
white sand	35	80
soft blue clay	80	220
hard blue clay	220	300
fine water sand	300	325
hard blue clay	325	420
fine water sand	420	435
coarse water sand	435	490

WELL LOCATION:
sec. 33 T 6 N R. 10 E W
Woodumbet
(distance) (direction) (nearest town)

WELL PURPOSE: none
(home, irrigation, municipal, industrial)

WELL COMPLETION DATA:
(1) diameter (inches) 2"
(2) total depth (feet) 490'
(3) static water level (feet) 20' below top of ground
(4) casing PVC, 480' (material) (depth)
(size) If telescope see back.
(5) screen 10' 480' (length) (depth to top)
2" PVC (size) (material)
(6) pump one 12 (HP) (yield gpm)
Etc (type power)
(7) electric log no (yes or no)
(organization running log)

(8) how well bottom plugged 24
with water valve


DRILLERS REMARKS:

RECEIVED
FEB 4 1977

MISS. BD. OF WATER COMM

If well telescopes please sketch and show depths.

GROUND LEVEL

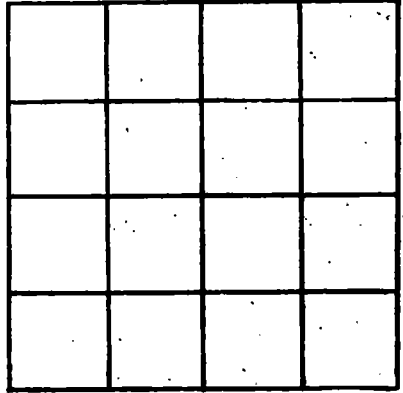

SECTION _____

Please indicate well location X.

ADDITIONAL INFORMATION

If more than one screen, show locations of each on sketch.