

Gorge

HARRISON  
H 2037  
1-18-77

MISSISSIPPI  
BOARD OF WATER COMMISSIONERS  
416 North State Street  
Jackson, Mississippi 39201

WATER WELL DRILLERS LOG  
COASTAL DRILLING & SERVICE CO.

Harrison

118  
date well completed

135  
1977

ROUTE 1 BOX 618

county well located

LANDOWNER: Boyd Krome  
MORNING MISS. 39532

description of formations encountered	from	to
Top Soil	1	3
Red Clay	3	18
White Sand	18	65
Soft Blue Clay	65	120
White Sand	120	185
Soft Blue Clay	185	180
Free Water Sand	180	200
Soft Blue Clay	200	340
Hard Blue Clay	340	415
Free Water Sand	415	420
Free Water Sand	420	465

Old Spring Way  
(mailing address)

WELL LOCATION:

sec 34 T 6 N R 10 E  
S W  
Wealumbok  
(distance) (direction) (nearest town)

WELL PURPOSE: none  
(home, irrigation, municipal, industrial)

WELL COMPLETION DATA:

- (1) diameter (inches) 24
- (2) total depth (feet) 465
- (3) static water level (feet) 40 below top of ground
- (4) casing PVC 45' (material) (depth)
- (5) screen 10' 455' (length) (depth to top)  
2" PVC (size) (material)
- (6) pump One 14 (HP) (yield gpm)  
Ele (type power)
- (7) electric log 700 (yes or no)
- (organization running log)


(8) how well bottom plugged at  
L. J. ...  
DRILLERS REMARKS:

RECEIVED  
JUN 16 1977

MISS. Bd. OF WATER COMM.

If well telescopes please sketch and show depths.

GROUND LEVEL

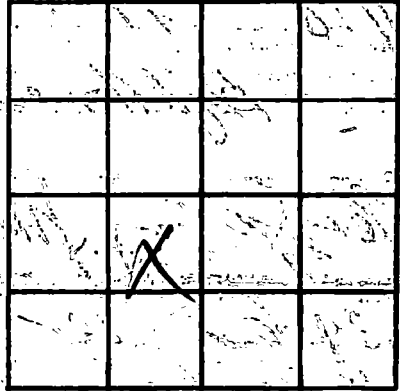

SECTION \_\_\_\_\_

Please indicate well location X.

**ADDITIONAL INFORMATION**

If more than one screen, show locations of each on sketch.