

HARRISON
H 239
4/12/77

MISSISSIPPI
BOARD OF WATER COMMISSIONERS
416 North State Street
Jackson, Mississippi 39201

WATER WELL DRILLERS LOG

4/12/77 1935 Coastal Drilling Harrison
date well completed firm name county well located
Biloxi, Miss

LANDOWNER: None planned
Rt 1 Box 745
Biloxi, Miss
Highway 201
(mailing address)

Description of formations encountered	from	to
Top Soil	4	4
Red Clay	4	17
Coarse white sand	17	44
3 ft blue clay	44	170
hard blue clay	170	285
Coarse white sand	285	305

WELL LOCATION:
sec 29 T 6 N R 10 E
S W
Woodmont
(distance) (direction) (nearest town)

WELL PURPOSE: home
(home, irrigation, municipal, industrial)

- WELL COMPLETION DATA:
- (1) diameter (inches) 2"
 - (2) total depth (feet) 305'
 - (3) static water level (feet) 50 below above top of ground.
 - (4) casing POC 295'
(material) (depth)
(size) If telescope see back.
 - (5) screen 10' 295'
(length) (depth to top)
2" POC
(size) (material)
 - (6) pump one 12
(HP) (yield gpm)
Ell
(type power)
 - (7) electric log no
(yes or no)
- (organization running log)

(8) how well bottom plugged 2 1/2" x 1 1/2" x 1/2" pipe

DRILLERS REMARKS:


RECEIVED

NOV 28 1977

COMM

If well telescopes please sketch and show depths.

GROUND LEVEL

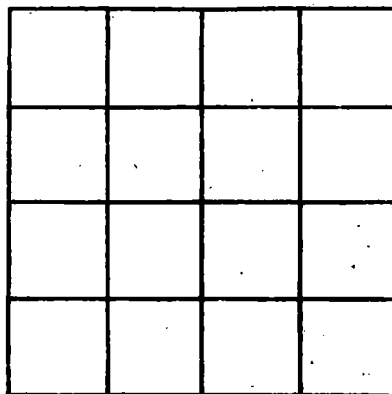

SECTION _____

Please indicate well location X.

ADDITIONAL INFORMATION

If more than one screen, show locations of each on sketch.