

HARRISON
H 2043
5-12-77

MISSISSIPPI
BOARD OF WATER COMMISSIONERS
416 North State Street
Jackson, Mississippi 39201

WATER WELL DRILLERS LOG
COASTAL DRILLING & SERVICE CO.

5/12/77
date well completed

ROUTE 1 BOX 618
BRIDGES, MISS 39532

Amuri
county well located

LANDOWNER: *Bob Williams*

description of formations encountered

from to

Rt 1 Box 70K
Piled, Miss
(mailing address)

<i>Top Soil</i>	<i>1</i>	<i>3</i>
<i>Silt & red clay</i>	<i>3</i>	<i>18</i>
<i>Red clay</i>	<i>18</i>	<i>40</i>
<i>white sand</i>	<i>40</i>	<i>85</i>
<i>5 ft blue clay</i>	<i>85</i>	<i>160</i>
<i>white sand</i>	<i>160</i>	<i>200</i>
<i>5 ft blue clay</i>	<i>200</i>	<i>315</i>
<i>hard blue clay</i>	<i>315</i>	<i>450</i>
<i>fine water sand</i>	<i>450</i>	<i>460</i>
<i>Coarse water sand</i>	<i>460</i>	<i>500</i>

WELL LOCATION:

sec *33* T *6N* R *10E*
S W
Woodburnet
(distance) (direction) (nearest town)

WELL PURPOSE: *home*
(home, irrigation, municipal, industrial)

WELL COMPLETION DATA:

- (1) diameter (inches) *2"*
- (2) total depth (feet) *500'*
- (3) static water level (feet) *45* below above top of ground.
- (4) casing *PVC 490'*
(material) (depth)
- (5) screen *10' 490'*
(length) (depth to top)
- 8"*
(size) *PVC*
(material)
- (6) pump *One 14*
(HP) (yield gpm)
- Ede*
(type power)
- (7) electric log *no*
(yes or no)

(organization running log)

(8) how well bottom plugged

L. (handwritten)


DRILLERS REMARKS:

RECEIVED
JUN 16 1977

MISS. BD. OF WATER COMM

If well telescopes please sketch and show depths.

GROUND LEVEL

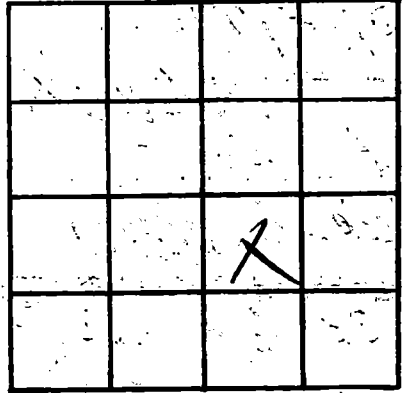

SECTION _____

Please indicate well location X.

ADDITIONAL INFORMATION

If more than one screen, show locations of each on sketch.