

Harrison
H 2055

MISSISSIPPI DEPARTMENT OF NATURAL RESOURCES
Bureau of Land and Water Resources
Southport Mall
P.O. Box 10631
Jackson, Mississippi 39209
WATER WELL DRILLERS LOG

March 19 1982 date well completed
Duncan Well Drilling Harrison firm name
Harrison county well located

LANDOWNER: Chester Donald
Rt. 2 Box 110 B
Shelport, Mo. 39503
(mailing address)

description of formations encountered	from	to
sand	0	40
Clay	40	80
sand & Clay	80	95
Blues Clay	95	117
Coarse Sand	117	132

WELL LOCATION:
sec. 30 T 6 N R 10 E
7 miles E of Shelport
(distance) (direction) (nearest town)

WELL PURPOSE: None
(home, irrigation, municipal, industrial)

- WELL COMPLETION DATA:
- (1) diameter (inches) 2"
 - (2) total depth (feet) 147 ft.
 - (3) static water level (feet) 15' below above top of ground.
 - (4) casing PVC 137 ft.
(material) (depth)
 - if telescope see back.
(size)
 - (5) screen 10' 137 ft.
(length) (depth to top)
 - 2" PVC
(size) (material)
 - (6) pump — —
(HP) (yield gpm)
 - electric
(type power)
 - (7) electric log —
(yes or no)
 - (organization running log)
 - (8) how well bottom plugged Sand
Shut

DRILLERS REMARKS: Dwyer
installed his
own pump.


DEPT. OF NATURAL RESOURCES
BUREAU OF LAND & WATER RESOURCES

AUG 30 1982

RECEIVED

If well telescopes please sketch and show depths.

GROUND LEVEL

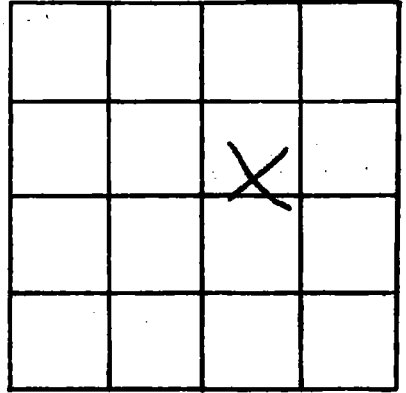

SECTION 30

Please indicate well location X.

ADDITIONAL INFORMATION

If more than one screen, show locations of each on sketch.