

MISSISSIPPI DEPARTMENT OF NATURAL RESOURCES

Bureau of Land and Water Resources

Southport Mall

P.O. Box 10631

Jackson, Mississippi 39209

WATER WELL DRILLERS LOG

Harrison
H 2056

Aug. 12 1982 Duncan Well Drilling Harrison
 date well completed firm name county well located

LANDOWNER: Herbert Kahar
Rt. 2 Box 301 H
Biloxi Mo.
 (mailing address)

description of formations encountered	from	to
White Clay	0	150
Fine Sand	150	220
Blue Clay	220	350
Course Sand	350	378

WELL LOCATION:
 sec 31 T 6 N R 9 E
15 miles N of Biloxi
 (distance) (direction) (nearest town)

WELL PURPOSE: None
 (home, irrigation, municipal, industrial)

- WELL COMPLETION DATA:
- (1) diameter (inches) 2"
 - (2) total depth (feet) 378 ft.
 - (3) static water level (feet) 10' below above top of ground.
 - (4) casing PVC, 368'
 (material) (depth)
 (size) If telescope see back.
 - (5) screen 10', 368'
 (length) (depth to top)
2" PVC
 (size) (material)
 - (6) pump 1 10
 (HP) (yield gpm)
electric
 (type power)
 - (7) electric log
 (yes or no)

(organization running log)
 (8) how well bottom plugged and
Mark

DRILLERS REMARKS:


DEPT. OF NATURAL RESOURCES
 BUREAU OF LAND & WATER RESOURCES

AUG 30 1982

RECEIVED

If well telescopes please sketch and show depths.

GROUND LEVEL

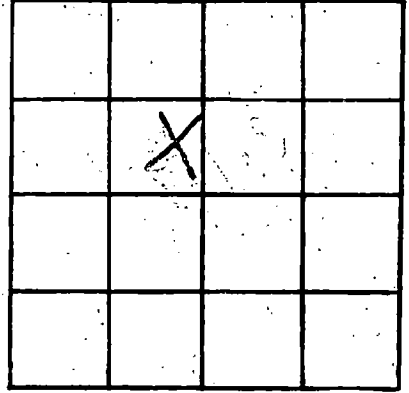

SECTION 31

Please indicate well location X.

ADDITIONAL INFORMATION

If more than one screen, show locations of each on sketch.