

MISSISSIPPI DEPARTMENT OF NATURAL RESOURCES

Bureau of Land and Water Resources

Southport Mall

P.O. Box 10631

Jackson, Mississippi 39209

WATER WELL DRILLERS LOG

Harrison
H
2057

May 11 1982 Duncan Well Drilling (Harrison)
 date well completed firm name county well located

LANDOWNER: Whymie Halley
Jim Byrd Road
Woolmarket, Ms.
 (mailing address)

description of formations encountered	from	to
Clay	0	15
Sand	15	30
White Clay	50	105
Blue Clay	105	390
Grey Sand	390	420
Course Sand	420	450

WELL LOCATION:
 sec 31 T 6 N R 10 E
2 miles E of Woolmarket
 (distance) (direction) (nearest town)

WELL PURPOSE: Home
 (home, irrigation, municipal, industrial)

WELL COMPLETION DATA:

(1) diameter (inches) 2"

(2) total depth (feet) 450 ft.

(3) static water level (feet) 60 ^{below} above top of ground.

(4) casing PVC 440'
 (material) (depth)

(size) 10' 440'
 If telescope see back. (length) (depth to top)

(5) screen 2" PVC
 (size) (material)

(6) pump 1 10
 (HP) (yield gpm)

electric
 (type power)

(7) electric log yes or no

(organization running log)

(8) how well bottom plugged Sand
Shark

DEPT. OF NATURAL RESOURCES
 BUREAU OF LAND & WATER RESOURCES


MAY 27 1982

RECEIVED

DRILLERS REMARKS:

If well telescopes please sketch and show depths.

GROUND LEVEL

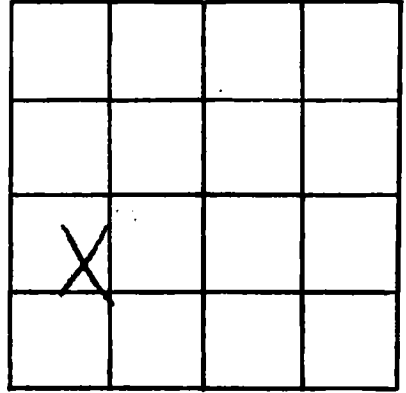

SECTION 34

Please indicate well location X.

ADDITIONAL INFORMATION

If more than one screen, show locations of each on sketch.