

MISSISSIPPI DEPARTMENT OF NATURAL RESOURCES

Bureau of Land and Water Resources

Southport Mall

P.O. Box 10631

Jackson, Mississippi 39209

COASTAL DRILLING & WELL DRILLERS LOG SERVICE CO.

ROUTE 1 BOX 618

BILOXI, MISS 39532

Harrison
county well located

Harrison
H
2061

11/27/82
date well completed

LANDOWNER: *Mr. Fred Robinson*

description of formations encountered

from to

Rt 5 Hwy 67
Bileci, Mo 39532
(mailing address)

<i>top soil</i>	<i>1</i>	<i>3</i>
<i>Red Clay</i>	<i>3</i>	<i>18</i>
<i>Red Sand</i>	<i>18</i>	<i>30</i>
<i>Spinel Sand</i>	<i>30</i>	<i>70</i>
<i>Soft Blue Clay</i>	<i>70</i>	<i>100</i>
<i>Red Sand</i>	<i>100</i>	<i>145</i>
<i>Soft Blue Clay</i>	<i>145</i>	<i>215</i>
<i>Spinel Sand</i>	<i>215</i>	<i>250</i>
<i>hard Blue Clay</i>	<i>250</i>	<i>420</i>
<i>fine water sand</i>	<i>420</i>	<i>460</i>
<i>Shell</i>	<i>460</i>	<i>465</i>
<i>hard Blue Clay</i>	<i>465</i>	<i>690</i>
<i>high water sand</i>	<i>690</i>	<i>725</i>
<i>good water sand</i>	<i>725</i>	<i>755</i>

WELL LOCATION:

sec. *24* T. *6* N. R. *10* E.
2 1/2 miles North *Walth* Pipeline
(distance) (direction) (nearest town)

WELL PURPOSE:

home
(home, irrigation, municipal, industrial)

WELL COMPLETION DATA:


- (1) diameter (inches) *2"*
- (2) total depth (feet) *770'*
- (3) static water level (feet) *60'* below above top of ground.
- (4) casing *2 1/2"* (material), *755'* (depth)
- (size) If telescope see back.
- (5) screen *15'* (length), *755'* (depth to top)
- 2"* (size), *2 1/2"* (material)
- (6) pump *1 1/2* (HP), *12* (yield gpm)
- Ele* (type power)
- (7) electric log *no* (yes or no)
- (organization running log)

(8) how well bottom plugged *2 1/2" inch wash*
DRILLERS REMARKS: *19-B*

DEPT. OF NATURAL RESOURCES
BUREAU OF LAND & WATER RESOURCES
RECEIVED
1982

If well telescopes please sketch and show depths.

GROUND LEVEL

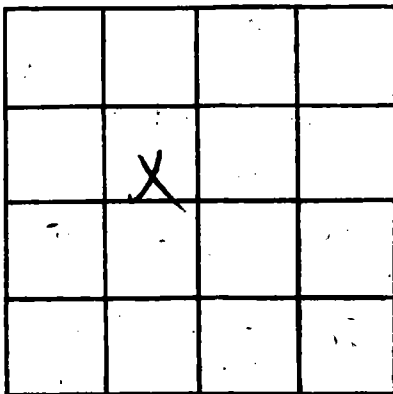

SECTION _____

Please indicate well location X.

ADDITIONAL INFORMATION

If more than one screen, show locations of each on sketch.