

MISSISSIPPI DEPARTMENT OF NATURAL RESOURCES

Bureau of Land and Water Resources

Southport Mall

P.O. Box 10631

Jackson, Mississippi 39209

WATER WELL DRILLERS LOG

COASTAL DRILLING & SERVICE CO.

Hansen  
H  
2062

4/20/82  
date well completed

ROUTE 1 BOX 618  
name

Hansen  
county well located

BILOXI MISS 39582

LANDOWNER: Tommy W. Hansen

description of formations encountered

from to

Hwy 67 Rt 5  
Billed: main  
(mailing address)

<u>top soil</u>	<u>1</u>	<u>2</u>
<u>red sand</u>	<u>2</u>	<u>15</u>
<u>blue red sand &amp; gravel</u>	<u>15</u>	<u>60</u>
<u>super sand</u>	<u>60</u>	<u>85</u>
<u>5 ft blue clay</u>	<u>85</u>	<u>165</u>
<u>super sand</u>	<u>165</u>	<u>200</u>
<u>5 ft blue clay</u>	<u>200</u>	<u>315</u>
<u>hard blue clay</u>	<u>315</u>	<u>465</u>
<u>fine water sand</u>	<u>465</u>	<u>500</u>
<u>good water sand</u>	<u>500</u>	<u>536</u>

WELL LOCATION:

sec 26 T 6 N R 10 E  
1/2 North mainline  
(distance) (direction) (nearest town)

WELL PURPOSE: home  
(home, irrigation, municipal, industrial)

WELL COMPLETION DATA:

- (1) diameter (inches) 4 1/2"
- (2) total depth (feet) 535'
- (3) static water level (feet) 70' below top of ground.
- (4) casing PVC 530'  
(material) (depth)
- 4 1/2" if telescope see back.  
(size)
- (5) screen 15' 530'  
(length) (depth to top)
- 2" PVC  
(size) (material)
- (6) pump 1/2 15  
(HP) (yield gpm)
- 3/4  
(type power)
- (7) electric log no  
(yes or no)

(organization running log)

(8) how well bottom plugged  
2" bad water valve

DRILLERS REMARKS: 19-B

DEPT. OF NATURAL RESOURCES  
BUREAU OF LAND & WATER RESOURCES

RECEIVED  
DEC 1 1982

If well telescopes please sketch and show depths.

GROUND LEVEL


160' 4" PVC Casing

360' 2" PVC Casing

15' 2" PVC Screen

2" ball wash valve

If more than one screen,  
show locations of each on sketch.

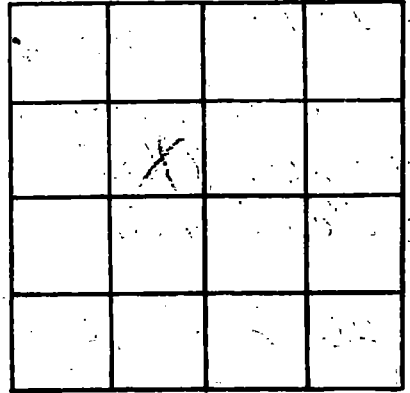

SECTION \_\_\_\_\_

Please indicate well location X.

ADDITIONAL INFORMATION

Multiple horizontal lines for additional information.