

MISSISSIPPI DEPARTMENT OF NATURAL RESOURCES

Bureau of Land and Water Resources

Southport Mall

P.O. Box 10631

Jackson, Mississippi 39209

COASTAL WATER WELL DRILLERS LOG
& SERVICE CO.

ROUTE 1 BOX 618

BILOXI, MISS. firm name 39532

county well located

Harrison
H
2063

date well completed

5/22/82

LANDOWNER John Beavin

description of formations encountered

from

to

lt N Box 97

top soil

1

3

Bahaki ms
(mailing address)

Red Clay

3

15

WELL LOCATION:

sec. 34 T 6 N R 10 E
S W
Inset F
(distance) miles (direction) of (nearest town)

Coarse white sand

15

40

WELL PURPOSE: home
(home, irrigation, municipal, industrial)

Swamp sand

40

60

WELL COMPLETION DATA:

(1) diameter (inches) 2"
(2) total depth (feet) 650
(3) static water level (feet) 30' below top of ground.

Soft Blue Clay

60

270

(4) casing PC 640'
(material) (depth)

fine water sand

270

310

(size) if telescope see back.

(5) screen 10' 640'
(length) (depth to top)

hard blue clay

310

460

2" PC
(size) (material)

fine water sand

460

490

(6) pump One' 14
(HP) (yield gpm)

hard blue clay

490

585

5hp
(type power)

fine water sand

585

620

(7) electric log no
(yes or no)

good water sand

620

650

(organization running log)

(8) how well bottom plugged
2" feet with clay



DRILLERS REMARKS: 198

DEPT. OF NATURAL RESOURCES
BUREAU OF LAND & WATER RESOURCES

DEC - 1 1982
RECEIVED

If well telescopes please sketch and show depths.

GROUND LEVEL

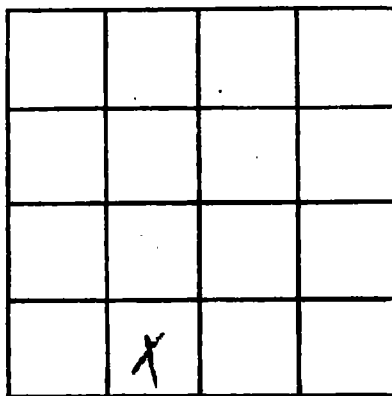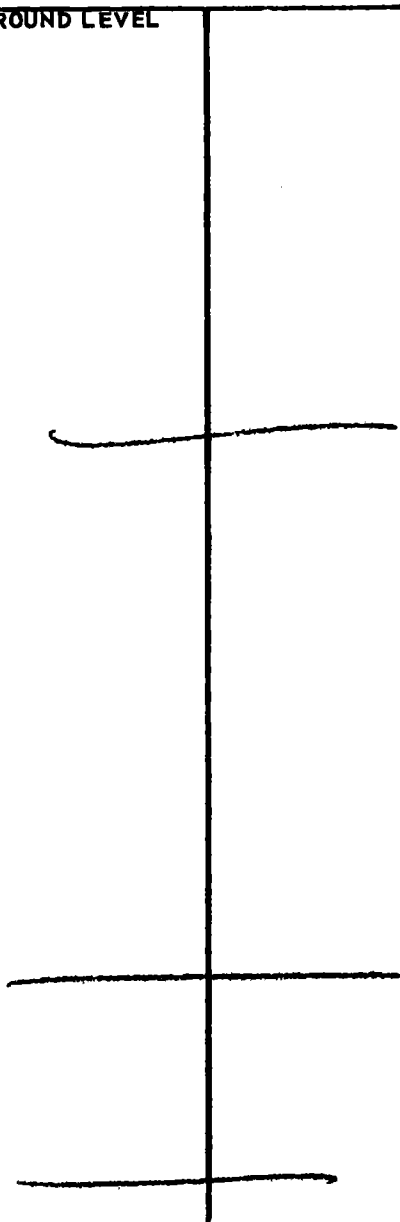

SECTION _____

Please indicate well location X.

ADDITIONAL INFORMATION

If more than one screen, show locations of each on sketch.