

Harrison
H
2064

MISSISSIPPI DEPARTMENT OF NATURAL RESOURCES
Bureau of Land and Water Resources
Southport Mall
P.O. Box 10631
Jackson, Mississippi 39209
WATER WELL DRILLERS LOG

2-2 1982 BRADEN PUMP & WELL SERVICE HARRISON
date well completed firm name county well located

LANDOWNER:
DISPOSAL SYSTEMS INC
1660 5th St
Biloxi MS 39530
(mailing address)

description of formations encountered from to
#10 HOLE

WELL LOCATION:
sec. 35 T. 6 N. R. 10 E
S W
2 miles NE of Woolmarket
(distance) (direction) (nearest town)

Sandy Soil - Surface 0 8
CLAY 8 12
SAND 12 22
CLAY & GRAVEL 22 35
WHITE CLAY 35 55
Blue CLAY 55 112
SAND 112 114
Blue CLAY 114 132
SAND 132 134
Blue CLAY 134 420

WELL PURPOSE: MONITORING
(home, irrigation, municipal, industrial)

WELL COMPLETION DATA:
(1) diameter (inches) 4"
(2) total depth (feet) 440
(3) static water level (feet) 60 below above top of ground.
(4) casing PVC 440 (material) (depth)
(size) If telescope see back.
(5) screen 5 ft 430 (length) (depth to top)
4 PVC (size) (material)
(6) pump (HP) (yield gpm)
(type power)
(7) electric log (yes or no)
(organization running log)
(8) how well bottom plugged 2" SAND & SHARK

SAND 420 437
Blue clay 437 440

Monitoring well


DEPT. OF NATURAL RESOURCES
BUREAU OF LAND & WATER RESOURCES

SEP 30 1982

RECEIVED

DRILLERS REMARKS:

If well telescopes please sketch and show depths.

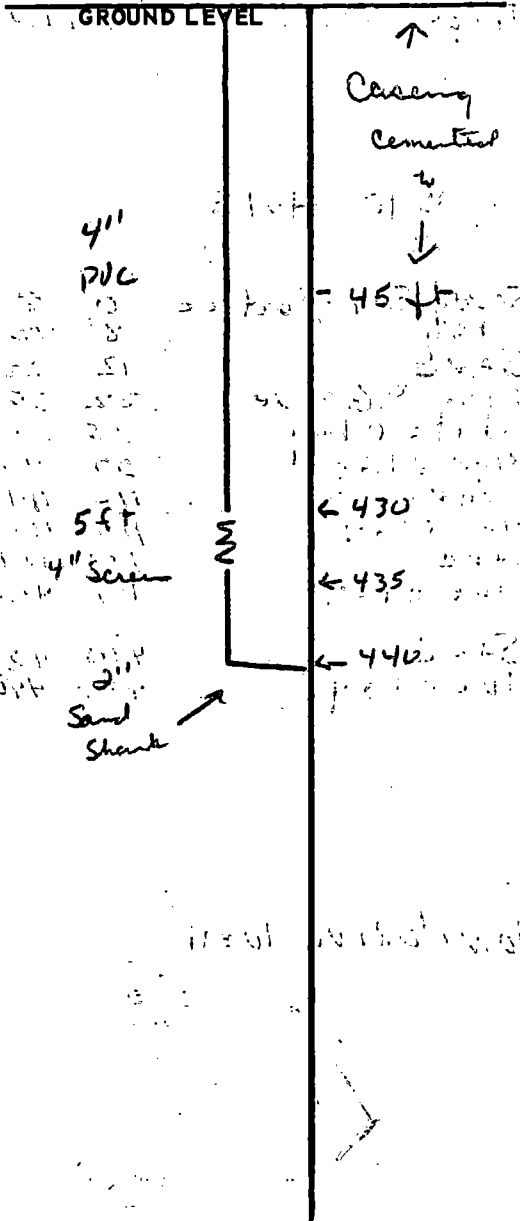

SECTION 36

Please indicate well location X.

ADDITIONAL INFORMATION

Series of horizontal lines for additional information.

If more than one screen, show locations of each on sketch.