

MISSISSIPPI DEPARTMENT OF NATURAL RESOURCES

Bureau of Land and Water Resources

Southport Mall

P.O. Box 10631

Jackson, Mississippi 39209

WATER WELL DRILLERS LOG

Harrison
H
2065

May 14 1982 *Duncan Well Drilling Harrison*  
 date well completed firm name county well located

LANDOWNER: *Bobby Redman*  
*512 Octaine Dr.*  
*Bellevue, Mo.*  
 (mailing address)

description of formations encountered	from	to
Clay	0	15
Sand	15	50
White & blue Clay	50	105
Blue Clay	105	390
fine Sand	390	400
Course Sand	400	420

WELL LOCATION:  
 sec 34 T 6 N R 10 E  
2 miles E of Woodman  
 (distance) (direction) (nearest town)

WELL PURPOSE: Home  
 (home, irrigation, municipal, industrial)

WELL COMPLETION DATA:

(1) diameter (inches) 2"

(2) total depth (feet) 420 ft.

(3) static water level (feet) 100' below above top of ground.

(4) casing PVC 410'  
 (material) (depth)  
 (size) If telescope see back.

(5) screen 10' 410'  
 (length) (depth to top)  
2" PVC  
 (size) (material)

(6) pump 1 10  
 (HP) (yield gpm)  
electric  
 (type power)

(7) electric log                       
 (yes or no)  
 (organization running log)

(8) how well bottom plugged Spd  
Shark

DRILLERS REMARKS:                     


DEPT. OF NATURAL RESOURCES  
 BUREAU OF LAND & WATER RESOURCES

AUG 27 1982

RECEIVED

If well telescopes please sketch and show depths.

GROUND LEVEL

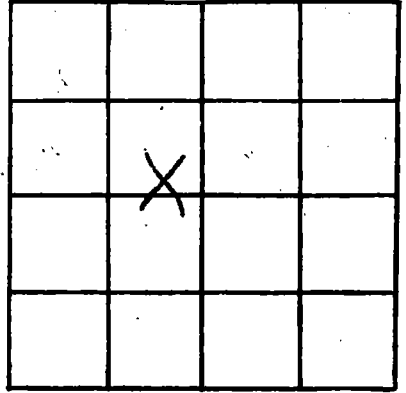

SECTION 34

Please indicate well location X.

ADDITIONAL INFORMATION

If more than one screen, show locations of each on sketch.