

HARRISON

H 2068

5-3-78

MISSISSIPPI BOARD OF WATER COMMISSIONERS 416 North State Street Jackson, Mississippi 39201

WATER WELL DRILLERS LOG

5/3/78 19 date well completed Coastal Valley Drilling & Service RT-1 Biloxi Miss Harrison county well located

LANDOWNER: Dennis Plummer

description of formations encountered

from to

Lynn John RT-1 Biloxi Miss (mailing address)

Top Soil	1	3
Red Clay	3	15
white sand	15	65
Soft Blue Clay	65	305
hard blue clay	305	400
fine white sand	400	420
Coarse white sand	420	440

WELL LOCATION:

sec 27 T 4 N R 10 E S W None north Woodstock (distance) (direction) (nearest town)

WELL PURPOSE:

(home, irrigation, municipal, industrial) home

WELL COMPLETION DATA:

- (1) diameter (inches) 2"
- (2) total depth (feet) 440'
- (3) static water level (feet) 50 below top of ground
- (4) casing PVC, 430' (depth)
- (5) screen 10' (length), 430' (depth to top), 2" (size), PVC (material)
- (6) pump one (HP), 10 (yield gpm), Ele (type power)
- (7) electric log no (yes or no)

(organization running log)

(8) how well bottom plugged 2" back wash valve

DRILLERS REMARKS:


RECEIVED

JUN 30 1978

MISS. BD. OF WATER COMM

If well telescopes please sketch and show depths.

GROUND LEVEL

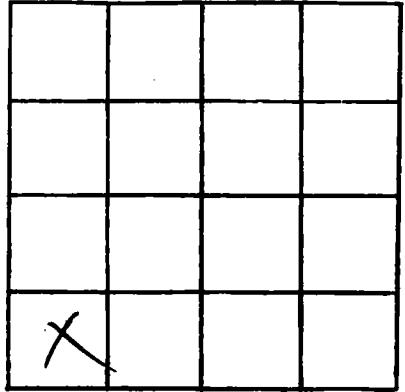

SECTION _____

Please indicate well location X.

ADDITIONAL INFORMATION

If more than one screen,
show locations of each on sketch.