

HARRISON
 H 2072
 6-15-78

MISSISSIPPI
 BOARD OF WATER COMMISSIONERS
 416 North State Street
 Jackson, Mississippi 39201

WATER WELL DRILLERS LOG

10/14/78 19 Coastal Drilling Harrison
 date well completed firm name county well located
Bilalgi Miss

LANDOWNER: J. Valente
Rt 5
Bilalgi Miss
 (mailing address)

WELL LOCATION:
 sec 29 T 6 N R 10 E
None miles North Woodville of
 (distance) (direction) (nearest town)


WELL PURPOSE: None
 (home, irrigation, municipal, industrial)

WELL COMPLETION DATA:
 (1) diameter (inches) 2"
 (2) total depth (feet) 328'
 (3) static water level (feet) 60 below
 top of ground.
 (4) casing PVC 318'
 (material) (depth)
 (size) If telescope see back.
 (5) screen 10' 318'
 (length) (depth to top)
2" PVC
 (size) (material)
 (6) pump 12
 (HP) (yield gpm)
Ele
 (type power)
 (7) electric log no
 (yes or no)
 (organization running log)

description of formations encountered	from	to
<u>top soil</u>	<u>1</u>	<u>3</u>
<u>fine sand</u>	<u>3</u>	<u>15</u>
<u>coarse white sand</u>	<u>15</u>	<u>40</u>
<u>5 ft blue clay</u>	<u>40</u>	<u>65</u>
<u>seam sand</u>	<u>65</u>	<u>100</u>
<u>5 ft blue clay</u>	<u>100</u>	<u>180</u>
<u>fine water sand</u>	<u>180</u>	<u>200</u>
<u>hard blue clay</u>	<u>200</u>	<u>290</u>
<u>fine water sand</u>	<u>290</u>	<u>310</u>
<u>fine water sand</u>	<u>310</u>	<u>328</u>

(8) how well bottom plugged
2" lead wire
 DRILLERS REMARKS:

Miss. Board of Water Comm.
 FEB 8 1979

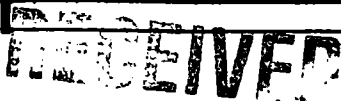

If well telescopes please sketch and show depths.

GROUND LEVEL

11	12	13	14
15	16	17	18
19	20	21	22
23	24	25	26

SECTION _____

Please indicate well location X:

ADDITIONAL INFORMATION

If more than one screen, show locations of each on sketch.