

HARRISON
 H 2078
 10-04-78

MISSISSIPPI
 BOARD OF WATER COMMISSIONERS
 416 North State Street
 Jackson, Mississippi 39201

WATER WELL DRILLERS LOG

10/4/78 date well completed
 Coastal Drilling Harrison firm name
 Biloxi Miss. county well located

LANDOWNER: Fern Donnell
Three Ruin Rd Rt I
Biloxi Miss.
 (mailing address)

description of formations encountered	from	to
	Top Soil	1
Red Clay	3	15
Coarse white sand	15	45
Soft Blue Clay	45	70
Coarse white sand	70	110
Soft Blue Clay	110	210
Coarse white sand	210	230
Soft Blue Clay	230	310
Hard Blue Clay	310	410
fine white sand	410	420
Coarse white sand	420	450

WELL LOCATION:
 sec. 19 T 6 N R. 10 E
1 1/2 miles North Woolmarket
 (distance) (direction) (nearest town)

WELL PURPOSE: home
 (home, irrigation, municipal, industrial)

WELL COMPLETION DATA:

(1) diameter (inches) 2"

(2) total depth (feet) 450'

(3) static water level (feet) 40 below above top of ground.

(4) casing PVC 440'
 (material) (depth)

(size) If telescope see back.

(5) screen 10' 440'
 (length) (depth to top)

2" PVC
 (size) (material)

(6) pump one 12
 (HP) (yield gpm)

ele
 (type power)

(7) electric log no
 (yes or no)

(organization running log)

(8) how well bottom plugged
2" (hard) water table

DRILLERS REMARKS:


Miss. Board of Water Comm.

APR 23 1978

RECEIVED

If well telescopes please sketch and show depths.

GROUND LEVEL

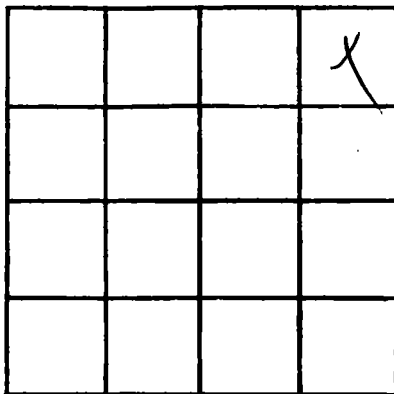

SECTION _____

Please indicate well location X.

ADDITIONAL INFORMATION

If more than one screen, show locations of each on sketch.