

HARRISON

H 2079

11-02-78

MISSISSIPPI BOARD OF WATER COMMISSIONERS 416 North State Street Jackson, Mississippi 39201

WATER WELL DRILLERS LOG

11/2/78 date well completed 19 Coastal Drilling firm name Harrison county well located

LANDOWNER: Willie Moran

description of formations encountered

from to

Rt 5

top soil

1 4

Biloxi Miss (mailing address)

Red Clay

4 20

WELL LOCATION:

sec 30 6 N R 10 E S W Minnewater Miss (distance) (direction) (nearest town)

Sugar Sand

20 65

Soft Red Clay

65 120

Soft Blue Clay

120 180

fine water sand

180 220

Hard Blue Clay

220 320

fine water sand

320 350

Hard Blue Clay

350 580

WELL PURPOSE:

(home, irrigation, municipal, industrial)

House

rock

580 82

fine water sand

82 630

fine water sand

630 670

WELL COMPLETION DATA:

- (1) diameter (inches) 2 1/2"
(2) total depth (feet) 680'
(3) static water level (feet) 40 below top of ground
(4) casing PVC 670' (material) (depth)
(5) screen 10' 670' (length) (depth to top)
(6) pump 1/2 HP 14 (yield gpm)
(7) electric log no (yes or no)

(organization running log)

(8) how well bottom plugged 2 1/2 inch well pipe

DRILLERS REMARKS:


Miss. Board of Water Comm.

APR 23 1979

RECEIVED

If well telescopes please sketch and show depths.

GROUND LEVEL

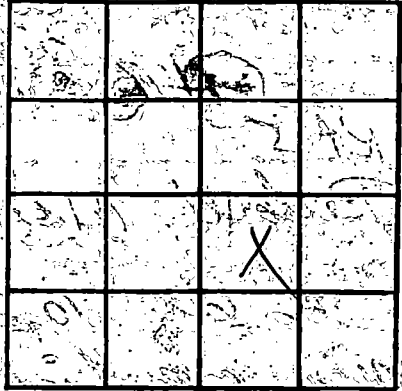

SECTION _____

Please indicate well location X.

ADDITIONAL INFORMATION

If more than one screen, show locations of each on sketch.