

HARRISON
 H 2080
 8-20-78

MISSISSIPPI
 BOARD OF WATER COMMISSIONERS
 416 North State Street
 Jackson, Mississippi 39201

WATER WELL DRILLERS LOG

date well completed 8/20/79 firm name Coastal Drilling county well located Harrison
Biloxi, Miss

LANDOWNER: see you
Rt 1 Box 868
Biloxi, Miss
 (mailing address)

WELL LOCATION:
 sec 27 T 6 N R 10 E
2 1/2 miles NE of Woodward
 (distance) (direction) (nearest town)

WELL PURPOSE: home
 (home, irrigation, municipal, industrial)

WELL COMPLETION DATA:
 (1) diameter (inches) 4 1/2"
 (2) total depth (feet) 525'
 (3) static water level (feet) 85' below
 top of ground.
 (4) casing ALC, 510'
 (material) (depth)
4 1/2" If telescope see back.
 (size)
 (5) screen 15', 510'
 (length) (depth to top)
2", PVC
 (size) (material)
 (6) pump 1/2 sub 20
 (HP) (yield gpm)
5hp
 (type power)
 (7) electric log no
 (yes or no)
 (organization running log)

description of formations encountered	from	to
Top Soil	1	2
Red Clay	2	18
Consolidated Sand	18	35
Swampy Sand	35	70
Soft Blue Clay	70	230
fine water sand	230	250
Hard Blue Clay	250	250
fine water sand	250	290
Coarse water sand	190	525

(8) how well bottom plugged
2" wood block valve
 DRILLERS REMARKS:

Miss. Board of Water Comm.


APR 16 1979

RECEIVED

If well telescopes please sketch and show depths.

GROUND LEVEL

200 ft 4" PVC Casings

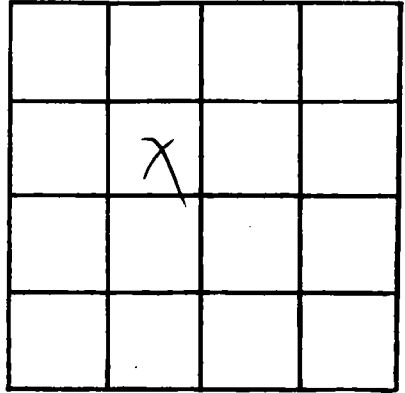

SECTION _____

Please indicate well location X.

ADDITIONAL INFORMATION

310' 2" PVC Casings

15 ft 2" PVC Casings

2" backwash valve
19-B

If more than one screen, show locations of each on sketch.