

HARRISON  
H 2086  
1-3-79

MISSISSIPPI  
BOARD OF WATER COMMISSIONERS  
416 North State Street  
Jackson, Mississippi 39201

WATER WELL DRILLERS LOG

COASTAL DRILLING & SERVICE CO. *Harrison*

1/3/79 19  
date well completed

ROUTE *1* BOX 618 county well located

LANDOWNER: *Harry Bell*

BOX *1* MISS. *39532*  
description of formations encountered

*Loney Bridge Road*  
*Bilati Min*  
*Bilati* (mailing address)

	from	to
<i>Top soil</i>	<i>1</i>	<i>3</i>
<i>Red clay</i>	<i>3</i>	<i>15</i>
<i>Coarse white sand</i>	<i>15</i>	<i>60</i>
<i>Soft blue clay</i>	<i>60</i>	<i>230</i>
<i>fine water sand</i>	<i>230</i>	<i>250</i>
<i>Soft blue clay</i>	<i>250</i>	<i>310</i>
<i>hard blue clay</i>	<i>310</i>	<i>420</i>
<i>fine water sand</i>	<i>420</i>	<i>450</i>
<i>good water sand</i>	<i>450</i>	<i>480</i>

WELL LOCATION:

sec *29* T *6* N R *9* E

*2 1/2* miles *N* *Charlottesville*  
(distance) (direction) (nearest town)

WELL PURPOSE: *line*  
(home, irrigation, municipal, industrial)

WELL COMPLETION DATA:

- (1) diameter (inches) *2"*
- (2) total depth (feet) *480'*
- (3) static water level (feet) *60* below top of ground.
- (4) casing *PVC*, *470'*  
(material) (depth)
- (size) if telescope see back.
- (5) screen *10'*, *470'*  
(length) (depth to top)
- 2"*, *PVC*  
(size) (material)
- (6) pump *One* *12*  
(HP) (yield gpm)
- 3hp*  
(type power)
- (7) electric log *no*  
(yes or no)

(organization running log)

(8) how well bottom plugged  
*2nd back wash valve*

DRILLERS REMARKS:  
*198*


Miss. Board of Water Comm.

MAY 16 1979

RECEIVED

If well telescopes please sketch and show depths.

GROUND LEVEL

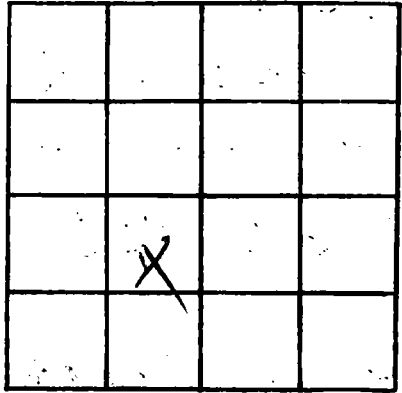

SECTION \_\_\_\_\_

Please indicate well location X.

ADDITIONAL INFORMATION

If more than one screen, show locations of each on sketch.