

HARRISON
H 2091
6-13-79

MISSISSIPPI
BOARD OF WATER COMMISSIONERS
416 North State Street
Jackson, Mississippi 39201
WATER WELL DRILLERS LOG

10-13 1979 Braden Pump and Harrison
date well completed firm name county well located

Well No. One

LANDOWNER: ~~Edward Gannon~~
Edward
Rt. 1, Box 785 H

Biloxi, MS 39532
(mailing address)

WELL LOCATION:
sec. 16 T. 6 N R. 10 E
3 miles NE of ~~unmarked~~
(distance) (direction) (nearest town)

WELL PURPOSE: none
(home, irrigation, municipal, industrial)

- WELL COMPLETION DATA:
- diameter (inches) 4" x 2"
 - total depth (feet) 480'
 - static water level (feet) 100' below top of ground.
 - casing PVC, total, (material) (depth)
4" x 2" (size) If telescope see back.
 - screen 10 ft, 470 (length) (depth to top)
2" PVC, (size) (material)
 - pump 1/2 sub, 20 (HP) (yield gpm)
 - electric log no (yes or no)
(organization running log)
 - how well bottom plugged 2" sand shark

description of formations encountered	depth	
	from	to
yellow clay	0	40
yellow clay + sand	40	60
yellow clay	60	100
sand	100	200
clay	200	240
sand	240	250
clay	250	275
gray sand	275	330
blue clay	330	400
sand	400	480

Miss. Board of Water Comm.

JUL 30 1979

RECEIVED

DRILLERS REMARKS:
~~_____~~
~~_____~~

If well telescopes please sketch and show depths.

GROUND LEVEL

4" dch 40 PVC

4" x 2" Bushing


2" dch 40 PVC

2" x 10 # PVC

240 ft

470 ft

480 ft

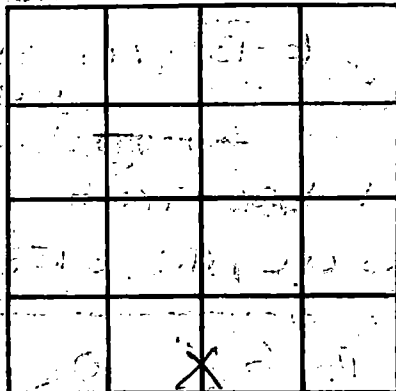

SECTION 16

Please indicate well location X.

ADDITIONAL INFORMATION

If more than one screen, show locations of each on sketch.