

HARRISON
H 2094
8-1-79

MISSISSIPPI
 BOARD OF WATER COMMISSIONERS
 416 North State Street
 Jackson, Mississippi 39201

WATER WELL DRILLERS LOG

Aug 1 1979 Braden Pump and Harrison
 date well completed fine name county well located
 Well Dr Inc.

LANDOWNER: George Hauer
 Rt 1, Box 785-A
 Biloxi, MS 39532
 (mailing address)

description of formations encountered	from	to
Red clay	0	80
Yellow clay	80	100
Blue clay	100	420
Sand	420	500

WELL LOCATION:
 sec 21 T. 6 S R 10 W
2 miles NE of Alvord Market
 (distance) (direction) (nearest town)

WELL PURPOSE: HOUSE
 (home, irrigation, municipal, industrial)

- WELL COMPLETION DATA:
- (1) diameter (inches) 2"
 - (2) total depth (feet) 500 ft
 - (3) static water level (feet) 10 ^{below} ~~above~~ top of ground.
 - (4) casing PVC (material), total (depth)
2" (size) if telescope see back.
 - (5) screen 10 ft (length), 420' (depth to top)
2" (size), arc under bar (material)
 - (6) pump 1' (HP), 5 (yield gpm)
220V 1 φ (type power)
 - (7) electric log NO (yes or no)

(organization running log)

(8) how well bottom plugged
2" sand gravel

DRILLERS REMARKS:


DEPT. OF NATURAL RESOURCES
 BUREAU OF LAND & WATER RESOURCES

OCT 16 1979

RECEIVED

If well telescopes please sketch and show depths.

GROUND LEVEL

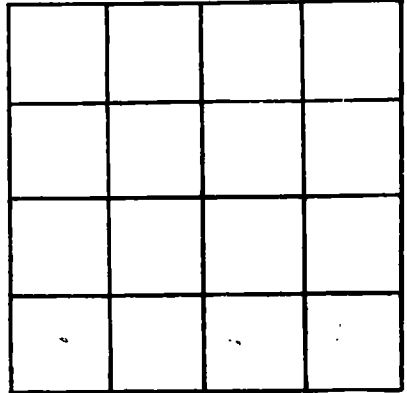

SECTION _____

Please indicate well location X.

ADDITIONAL INFORMATION

If more than one screen, show locations of each on sketch.