

HARRISON
H 2095
10-09-79

MISSISSIPPI
 BOARD OF WATER COMMISSIONERS
 416 North State Street
 Jackson, Mississippi 39201

WATER WELL DRILLERS LOG

10/19/79 date well completed 19 79 Lyman Well firm name Harrison county well located.

LANDOWNER: Ms Sgt. [unclear]
Biloxi

description of formations encountered	from	to
<u>Red clay</u>	<u>0</u>	<u>12</u>
<u>Red white clay</u>	<u>12</u>	<u>18</u>
<u>Blue clay</u>	<u>18</u>	<u>210</u>
<u>grey - fine - sand</u>	<u>210</u>	<u>218</u>
<u>Blue clay sand</u>	<u>218</u>	<u>490</u>
	<u>490</u>	<u>526</u>

(mailing address)

WELL LOCATION:
 sec. 32 T. 6 N. R. 9 E
7 miles N of Biloxi
 (distance) (direction) (nearest town)

WELL PURPOSE: Home
 (home, irrigation, municipal, industrial)

WELL COMPLETION DATA:

- (1) diameter (inches) 2 1/2
- (2) total depth (feet) 526
- (3) static water level (feet) 23 ^{below} _{above} top of ground
- (4) casing PVC 526
 (material) (depth)
 (size) If telescope see back.
- (5) screen 10' 516
 (length) (depth to top)
8 slot PVC
 (size) (material)
- (6) pump 1 70
 (HP) (yield gpm)
 (type power)
- (7) electric log _____
 (yes or no)
 (organization running log)
- (8) how well bottom plugged Wash check


DRILLERS REMARKS:

DEPT. OF NATURAL RESOURCES
 BUREAU OF LAND & WATER RESOURCES

JAN 7 1980
 RECEIVED

If well telescopes please sketch and show depths.

GROUND LEVEL

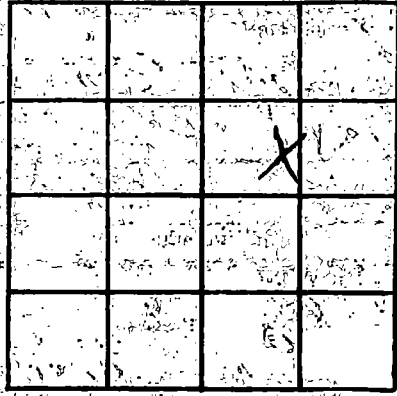

SECTION 32

Please indicate well location X.

ADDITIONAL INFORMATION

If more than one screen, show locations of each on sketch.