

HARRISON  
H 2099  
11-7-79

MISSISSIPPI  
 BOARD OF WATER COMMISSIONERS  
 416 North State Street  
 Jackson, Mississippi 39201

WATER WELL DRILLERS LOG

CODED

11-7 1979 Bradon Pump Harrison  
 date well completed firm name county well located

Ernest Applewhite  
 LANDOWNER:  
Sanitary Landfill Co.  
P.O. Box 2115  
Pascagoula, MS 39567  
 (mailing address)

| description of formations encountered | from to |     |
|---------------------------------------|---------|-----|
|                                       |         |     |
| Clay                                  | 0       | 20  |
| Sands                                 | 20      | 60  |
| Clay                                  | 60      | 100 |
| Sands                                 | 100     | 130 |
| Blue clay                             | 130     | 200 |
| et Sand                               | 200     | 280 |

WELL LOCATION:  
 sec 31 T 6 S R 10 W  
2 miles W of Woodmarket  
 (distance) (direction) (nearest town)

WELL PURPOSE: Home  
 (home, irrigation, municipal, industrial)

WELL COMPLETION DATA:

(1) diameter (inches) 2"

(2) total depth (feet) 280'

(3) static water level (feet) 0 below above top of ground.

(4) casing PVC total (material) (depth)  
2" (size) if telescope see back.

(5) screen 10' 270 (length) (depth to top)  
2" (size) PVC (material)

(6) pump 1/2 section 10 (HP) (yield gpm)  
0.115 V (type power)

(7) electric log NO (yes or no)

(organization running log)

(8) how well bottom plugged  
2" sand shark

DRILLERS REMARKS:  
no tail pipe


DEPT. OF NATURAL RESOURCES  
 BUREAU OF LAND & WATER RESOURCES

FEB 15 1980

RECEIVED

If well telescopes please sketch and show depths.

GROUND LEVEL

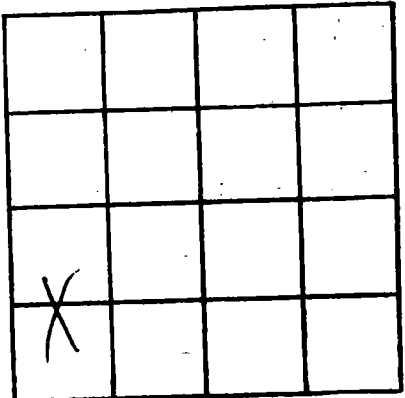

SECTION 31

Please indicate well location X.

ADDITIONAL INFORMATION

Lined area for additional information.

If more than one screen, show locations of each on sketch.