

HARRISON
H 2004
4-18-80

MISSISSIPPI
BOARD OF WATER COMMISSIONERS
416 North State Street
Jackson, Mississippi 39201

WATER WELL DRILLERS LOG

4-18 1980 Braden Pump Well Harrison
date well completed firm name county well located
Service, Inc

LANDOWNER:
Herbert Kuhn
210 Boardman Blvd
Gulfport MS
(mailing address)

description of formations encountered	from	to
Clay	0	130
Sand	130	150
Clay	150	300
Sand	300	340

WELL LOCATION:
sec 32 T 6 N R 9 E
S W
2 1/2 miles N of Daberville
(distance) (direction) (nearest town)

WELL PURPOSE: HOME
(home, irrigation, municipal, industrial)

- WELL COMPLETION DATA:
- diameter (inches) 4" x 2"
 - total depth (feet) 340'
 - static water level (feet) 30' below top of ground.
 - casing PVC, total 4" x 2" (size) if telescope see back.
 - screen 10' (length), 325' (depth to top) 2" (size), 100% PVC underdrain (material)
 - pump 1/2 sub 15 (HP) (yield gpm) 225 (type power)
 - electric log NO (yes or no)
- (organization running log)
- (8) how well bottom plugged 2" sand shark

DRILLERS REMARKS:
5' tail pipe

DEPT. OF NATURAL RESOURCES
BUREAU OF LAND & WATER RESOURCES
MAY 5 - 1980
RECEIVED

If well telescopes please sketch and show depths.


GROUND LEVEL

4" sch 40
PVC →

4" x 2" 160' →
Hex Bushing

2" sch 40
PVC

325' →
2" 008 PVC
Under bar
340'

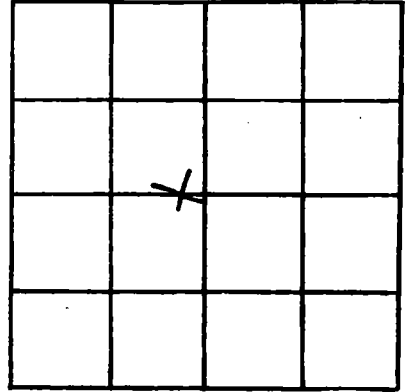

SECTION 3A

Please indicate well location X.

ADDITIONAL INFORMATION

If more than one screen,
show locations of each on sketch.