

HARRISON

H 2106

4-14-79

MISSISSIPPI BOARD OF WATER COMMISSIONERS
416 North State Street
Jackson, Mississippi 39201

WATER WELL DRILLERS LOG

COASTAL DRILLING & SERVICE CO.

4/14 1979
date well completed

ROUTE 7 BOX 618 county well located

LANDOWNER Billy Glenn

description of formations encountered	from	to
top soil	1	3
red clay	3	18
orange yellow sand	18	24
soft blue clay	24	120
fine water sand	120	140
hard blue clay	140	275
fine water sand	275	300
good water sand	300	320

Cedar Lake

Biloxi, Miss. 39532
Biloxi, Miss.
(mailing address)

WELL LOCATION:

sec 25 T 6 N R 10 E
1 1/2 miles Road Cedar Lake
(distance) (direction) (nearest town)

WELL PURPOSE: home
(home, irrigation, municipal, industrial)

WELL COMPLETION DATA:

- (1) diameter (inches) 2'
- (2) total depth (feet) 320'
- (3) static water level (feet) 25' below top of ground.
- (4) casing AC 310' (material) (depth)
- (size) If telescope see back.
- (5) screen 10' 310' (length) (depth to top)
- 2" PVC (size) (material)
- (6) pump one 14 (HP) (yield gpm)
- Ele (type power)
- (7) electric log no (yes or no)

(organization running log)

(8) how well bottom plugged
2" sand wash water

DRILLERS REMARKS: 19-6


DEPT. OF NATURAL RESOURCES
BUREAU OF LAND & WATER RESOURCES

OCT 31 1980

RECEIVED

If well telescopes please sketch and show depths.

GROUND LEVEL

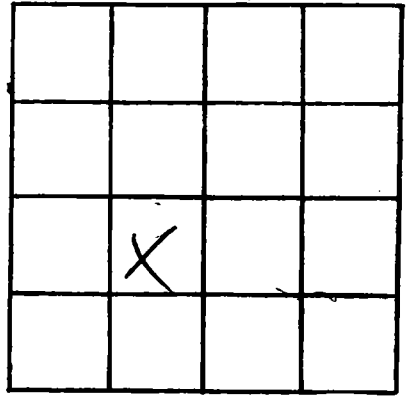

SECTION _____

Please indicate well location X.

ADDITIONAL INFORMATION

If more than one screen, show locations of each on sketch.