

HARRISON
H 2108
5/9/79

MISSISSIPPI
BOARD OF WATER COMMISSIONERS
416 North State Street
Jackson, Mississippi 39201

WATER WELL DRILLERS LOG
COASTAL DRILLING & SERVICE CO.

5/9 1979
date well completed

Box 018
well name

Harrison
county well located

LANDOWNER

Doris Varnado

STUART, MISS. 39532
description of formations encountered

from to

John Cow Rd
Hpt. Miss
(mailing address)

Top Soil	1	3
Red Clay	3	15
Super Sand	15	35
Red Clay	35	70
Hard Blue Clay	70	210
fine water sand	210	220
Coarse water sand	220	240

WELL LOCATION:

sec 34 T 6 N R 10 E
S W

Miles S of
(distance) (direction) (nearest town)

WELL PURPOSE:

Home
(home, irrigation, municipal, industrial)

WELL COMPLETION DATA:

- (1) diameter (inches) 2"
- (2) total depth (feet) 240'
- (3) static water level (feet) 20' below top of ground
- (4) casing PVC, 230' (material) (depth)

(size) If telescope see back.

- (5) screen 10' length, 230' (depth to top)

2" (size) PVC (material)

- (6) pump One 14 (HP) (yield gpm)

Ele (type power)

- (7) electric log No (yes or no)

(organization running log)

- (8) how well bottom plugged

2" bed with valve

DRILLERS REMARKS: 19-B


DEPT. OF NATURAL RESOURCES
BUREAU OF LAND & WATER RESOURCES

OCT 31 1980

RECEIVED

If well telescopes please sketch and show depths.

GROUND LEVEL

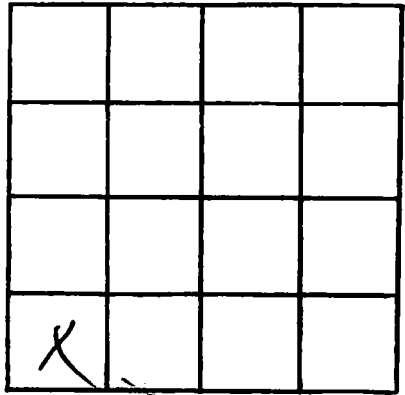

SECTION _____

Please indicate well location X.

ADDITIONAL INFORMATION

If more than one screen,
show locations of each on sketch.