

MISSISSIPPI DEPARTMENT OF NATURAL RESOURCES

Bureau of Land and Water Resources

Southport Mall

P.O. Box 10631

Jackson, Mississippi 39209

WATER WELL DRILLERS LOG

COASTAL DRILLING & SERVICE CO.

HARRISON
H 2112
4-25-80

date well completed 4/25 1980

ROUTE 1 name BOX 618

Harrison county well located

LANDOWNER: Charles J. Tuttle

MISS. 39532 description of formations encountered	from	to
Top Soil	1	3
Red Clay	3	15
Coarse white sand	15	30
Soft Blue Clay	30	45
Coarse white sand	45	80
Soft Blue Clay	80	190
fine water sand	190	230
hard blue clay	230	400
fine water sand	400	410
Good Water Sand	410	460

John Baddeley Pt 1
Bilbo's Min
(mailing address)

WELL LOCATION:

sec. 34 T. 6 N. R. 10 E. S. 1 W.
2 1/2 miles East Coahoma
(distance) (direction) (nearest town)

WELL PURPOSE: home
(home, irrigation, municipal, industrial)

WELL COMPLETION DATA:

- (1) diameter (inches) 2"
- (2) total depth (feet) 460'
- (3) static water level (feet) 40' below top of ground.
- (4) casing PVC 430'
(material) (depth)
- (size) If telescope see back.
- (5) screen 10' 430'
(length) (depth to top)
- 2" PVC
(size) (material)
- (6) pump one 14
(HP) (yield gpm)
- 5hp
(type power)
- (7) electric log no
(yes or no)

(organization running log)

(8) how well bottom plugged 2" back with valve

DRILLERS REMARKS: 19-B


DEPT. OF NATURAL RESOURCES
BUREAU OF LAND & WATER RESOURCES

NOV - 5 1980

RECEIVED

If well telescopes please sketch and show depths.

GROUND LEVEL

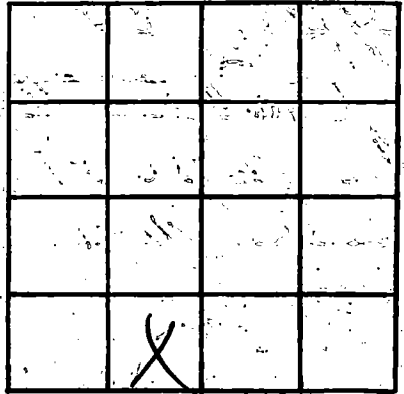

SECTION _____

Please indicate well location X.

ADDITIONAL INFORMATION

If more than one screen, show locations of each on sketch.