

HARRIS
H 2114
8/5/80

MISSISSIPPI
BOARD OF WATER COMMISSIONERS
416 North State Street
Jackson, Mississippi 39201

WATER WELL DRILLERS CO. Co.

8/5/80 date well completed 19
John Albert firm name
Harrison county well located

LANDOWNER: John Albert
Rte 2 Box 288 A
Biloxi, Md
(mailing address)

description of formations encountered	from	to
yellow clay	0	11
white sand & gravel	11	26
grey clay	26	70
blue clay	70	288
SAND PAK	288	318

WELL LOCATION:
sec. 25 T 6 N R 10 E
7 miles (distance) of Biloxi (nearest town)

WELL PURPOSE: home
(home, irrigation, municipal, industrial)

WELL COMPLETION DATA:
(1) diameter (inches) 2"
(2) total depth (feet) 318'
(3) static water level (feet) 54' below above top of ground.
(4) casing PVC 308'
(material) (depth)
2" (size) if telescope see back.
(5) screen 10' 308'
(length) (depth to top)
6 slot PVC
(size) (material)
(6) pump 1 11
(HP) (yield gpm)
electric
(type power)
(7) electric log 110
(yes or no)
(organization running log)

(8) how well bottom plugged Sand
Shark

DRILLERS REMARKS:


DEPT. OF NATURAL RESOURCES
BUREAU OF LAND & WATER RESOURCES

NOV - 6 1980

RECEIVED

If well telescopes please sketch and show depths.

GROUND LEVEL

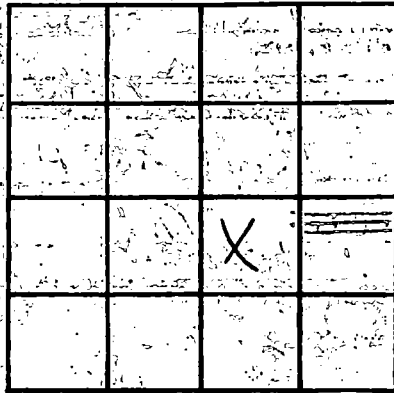

SECTION

25

Please indicate well location X.

ADDITIONAL INFORMATION

A series of 20 horizontal lines for entering additional information.

If more than one screen, show locations of each on sketch.

DEPT. OF NATURAL RESOURCES
 DIVISION OF WATER RESOURCES
 DIVISION OF WATER RESOURCES