

MISSISSIPPI DEPARTMENT OF NATURAL RESOURCES

Bureau of Land and Water Resources

Southport Mall

P.O. Box 10631

Jackson, Mississippi 39209

WATER WELL DRILLERS LOG

COASTAL DRILLING & SERVICE CO. *Harrison*

ROUTE # *1* BOX 618

county well located

HARRISON
H 2115
10-19-79

date well completed *10/19/79*

LANDOWNER *John Jadinic* BILOXI, MISS 39532

description of formations encountered

from to

Fajal Rd
Biloxi, Miss
(mailing address)

<i>top soil</i>	<i>1</i>	<i>3</i>
<i>red clay</i>	<i>3</i>	<i>40</i>
<i>yellow sand</i>	<i>40</i>	<i>65</i>
<i>buff white sand</i>	<i>65</i>	<i>110</i>
<i>soft blue clay</i>	<i>110</i>	<i>230</i>
<i>fine, white silt</i>	<i>230</i>	<i>250</i>
<i>hard blue clay</i>	<i>250</i>	<i>410</i>
<i>gray water sand</i>	<i>410</i>	<i>443</i>

WELL LOCATION:

sec. *36* T. *6* N. R. *10* E. W. *10*
1/2 north *Cedar Lake*
(distance) (direction) (nearest town)

WELL PURPOSE: *farm*
(home, irrigation, municipal, industrial)

WELL COMPLETION DATA:

- (1) diameter (inches) *2"*
- (2) total depth (feet) *443*
- (3) static water level (feet) *20'* below above top of ground.
- (4) casing *PVC*, *433'*
(material) (depth)
(size) if telescope see back.
- (5) screen *10'*, *433'*
(length) (depth to top)
2", *PVC*
(size) (material)
- (6) pump *1 1/2*, *10*
(HP) (yield gpm)
ELC
(type power)
- (7) electric log *no*
(yes or no)

(organization running log)

(8) how well bottom plugged *2" back w/ gravel*

DRILLERS REMARKS: *19-B*


DEPT. OF NATURAL RESOURCES
BUREAU OF LAND & WATER RESOURCES

NOV - 5 1980

RECEIVED

If well telescopes please sketch and show depths.

GROUND LEVEL

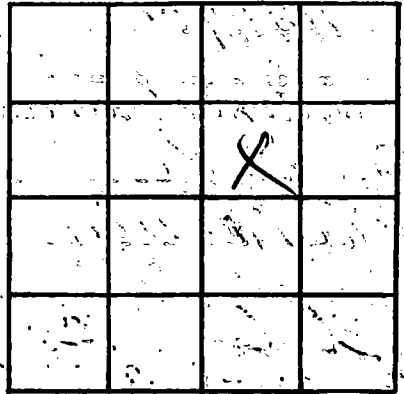

SECTION _____

Please indicate well location X.

ADDITIONAL INFORMATION

If more than one screen, show locations of each on sketch.