

MISSISSIPPI DEPARTMENT OF NATURAL RESOURCES

Bureau of Land and Water Resources

Southport Mall

P.O. Box 10631

Jackson, Mississippi 39209

WATER WELL DRILLERS LOG

COASTAL DRILLING & SERVICE CO.

HARRISON
H 2116
4-2-80
4/2/80

date well completed

ROULET name BOX 618

county well located

LANDOWNER

Bell Wheeler

description of formations encountered

from

to

Hubert

Top Soil

1

3

Biladi' Davis

Red Clay

3

15

(mailing address)

Orange water sand

15

45

WELL LOCATION:

sec. *22* T. *6* N. R. *10* E. S. *5* W.

S.M. Blue Clay

45

235

3 1/2 miles NE *Coahoma*

(distance)

(direction)

(nearest town)

Orange water sand

235

260

Hard Blue Clay

240

470

WELL PURPOSE:

(home, irrigation, municipal, industrial)

home

Orange water sand

490

715

Orange water sand

715

750

WELL COMPLETION DATA:

(1) diameter (inches)

2"

(2) total depth (feet)

750'

(3) static water level (feet)

60' below above

top of ground.

(4) casing

AK

735'

(material)

(depth)

(size) if telescope see back.

(5) screen

15'

735'

(length)

(depth to top)

2"

(size)

PVC

(material)

(6) pump

one

12

(HP)

(yield gpm)

ele

(type power)

(7) electric log

no

(yes or no)

(organization running log)

(8) how well bottom plugged

2" back wash valve

DRILLERS REMARKS:


DEPT. OF NATURAL RESOURCES
BUREAU OF LAND & WATER RESOURCES

JAN 23 1981

RECEIVED

If well telescopes please sketch and show depths.

GROUND LEVEL

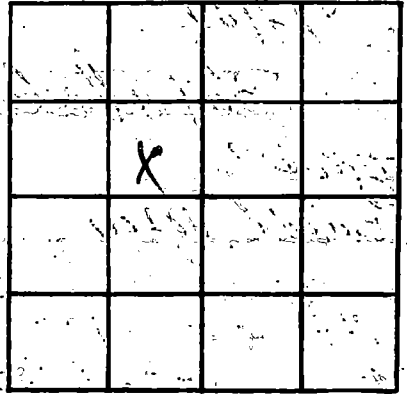

SECTION _____

Please indicate well location X.

ADDITIONAL INFORMATION

If more than one screen, show locations of each on sketch.