

MISSISSIPPI DEPARTMENT OF NATURAL RESOURCES

Bureau of Land and Water Resources

Southport Mall

P.O. Box 10631

Jackson, Mississippi 39209

WATER WELL DRILLERS LOG
COASTAL DRILLING & SERVICE CO.

ROUTE 1 BOX 619

firm name
BILLOVI, MISS. 39532

Harrison
county well located

HARRISON
H 2119
7-12-80
7/12/80

date well completed

LANDOWNER:

Billy Boyd

description of formations encountered

from to

Comm. P.

top soil

1 3

Long Beach Min
(mailing address)

Red Clay

3 15

WELL LOCATION:

sec. 25 T. 6 N. R. 10 E.

Coar. white sand

15 30

(3) Three miles North Cedar Lake
(distance) (direction) of (nearest town)

Sandy Sand

30 45

WELL PURPOSE:

(home, irrigation, municipal, industrial)

Light Blue Clay

45 210

WELL COMPLETION DATA:

- (1) diameter (inches) 2"
(2) total depth (feet) 390'
(3) static water level (feet) 30' below above top of ground.

Hard Blue Clay

210 315

- (4) casing PVC 380'
(material) (depth)

(size) if telescope see back.

- (5) screen 10' 380'
(length) (depth to top)

2" PVC
(size) (material)

- (6) pump one 12
(HP) (yield gpm)

etc
(type power)

- (7) electric log no
(yes or no)

(organization running log)

DEPT. OF NATURAL RESOURCES
BUREAU OF LAND & WATER RESOURCES

- (8) has well bottom plugged.
2" backwash valve


JAN 23 1981

DRILLERS REMARKS:

RECEIVED

If well telescopes please sketch and show depths.

GROUND LEVEL

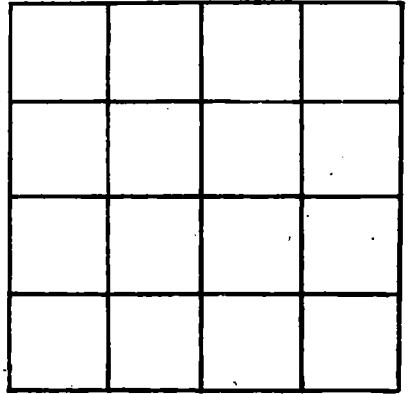

SECTION _____

Please indicate well location X.

ADDITIONAL INFORMATION

If more than one screen,
show locations of each on sketch.