

MISSISSIPPI DEPARTMENT OF NATURAL RESOURCES

Bureau of Land and Water Resources

Southport Mall

P.O. Box 10631

Jackson, Mississippi 39209

WATER WELL DRILLERS LOG
COASTAL DRILLING & SERVICE CO.

ROUTE 1 BOX 618

Firm name
BILLOVI, MISS. 39532

county well located

HARRISON
H 2120
7-30-80
7/30/80
date well completed

Harrison

LANDOWNER: H.A. May

Rt 5 Kahok Rd

Billevi Miss
(mailing address)

WELL LOCATION:

sec 25 T 6N R 10E
2 1/2 miles north Cody Lake
(distance) (direction) (nearest town)

WELL PURPOSE: home
(home, irrigation, municipal, industrial)

WELL COMPLETION DATA:

- (1) diameter (inches) 2"
- (2) total depth (feet) 330'
- (3) static water level (feet) 60' below top of ground.
- (4) casing PVC 320'
(material) (depth)
- (size) if telescope see back.
- (5) screen 10' 320'
(length) (depth to top)
- 2" PVC
(size) (material)
- (6) pump one 8
(HP) (yield gpm)
- GLC
(type power)
- (7) electric log no
(yes or no)

(organization running log)

2 1/2 feet well bottom plugged 9-5

description of formations encountered

from to

<u>top soil</u>	<u>1</u>	<u>3</u>
<u>red clay</u>	<u>3</u>	<u>18</u>
<u>fine white sand</u>	<u>18</u>	<u>40</u>
<u>Sierra Sand</u>	<u>40</u>	<u>80</u>
<u>Soft Blue Clay</u>	<u>80</u>	<u>210</u>
<u>hard Blue Clay</u>	<u>210</u>	<u>285</u>
<u>fine water sand</u>	<u>285</u>	<u>300</u>
<u>good water sand</u>	<u>300</u>	<u>330</u>

DEPT. OF NATURAL RESOURCES
BUREAU OF LAND & WATER RESOURCES


JAN 21 1981

RECEIVED

DRILLERS REMARKS:

If well telescopes please sketch and show depths.

GROUND LEVEL

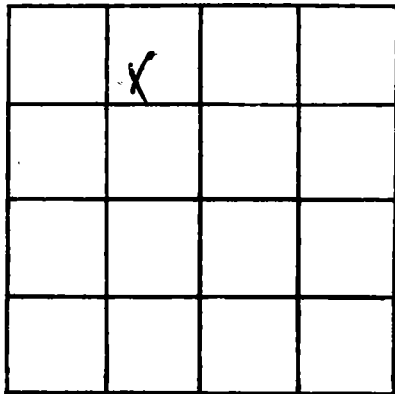

SECTION _____

Please indicate well location X.

ADDITIONAL INFORMATION

If more than one screen,
show locations of each on sketch.