

MISSISSIPPI DEPARTMENT OF NATURAL RESOURCES

Bureau of Land and Water Resources

Southport Mall

P.O. Box 10631

Jackson, Mississippi 39209

WATER WELL DRILLERS LOG
COASTAL DRILLING & SERVICE CO.

ROUTE 1 BOX 618

firm name
BILOXI, MISS. 39532

county well located

HARRISON
H 2121

9-15-80
9/15/80
date well completed

Harrison

LANDOWNER: W. T. Turner

Rt. 1 Box 705 B

Biloxi Min

(mailing address)

description of formations encountered

from

to

Top soil

1 3

Red Clay

3 15

Coarse white sand

15 35

Soft Blue Clay

35 130

Hard Blue Clay

130 195

fine water sand

195 200

good water sand

200 220

WELL LOCATION:

sec. 34 T 6 N R 10 E

Woolbrook

(distance) (direction) of (nearest town)

WELL PURPOSE: home
(home, irrigation, municipal, industrial)

WELL COMPLETION DATA:

- (1) diameter (inches) 2"
- (2) total depth (feet) 220'
- (3) static water level (feet) 40' below top of ground
- (4) casing PVC 210'
(material) (depth)
- (size) if telescope see back.
- (5) screen 10' 210'
(length) (depth to top)
- 2" PVC
(size) (material)
- (6) pump ONE 12
(HP) (yield gpm)
- 5hp
(type power)
- (7) electric log no
(yes or no)

(organization running log)

(8) how well bottom plugged

back with valve

DRILLERS REMARKS:


DEPT. OF NATURAL RESOURCES
BUREAU OF LAND & WATER RESOURCES

JAN 12 1981

RECEIVED

If well telescopes please sketch and show depths.

GROUND LEVEL

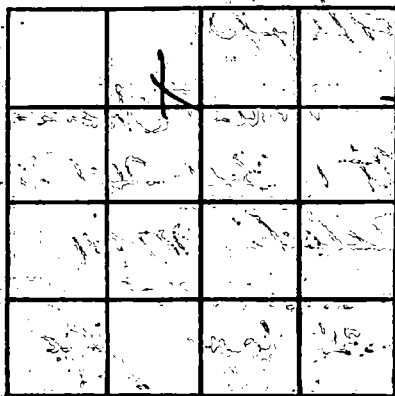

SECTION _____

Please indicate well location X.

ADDITIONAL INFORMATION

If more than one screen, show locations of each on sketch.