

MISSISSIPPI DEPARTMENT OF NATURAL RESOURCES

Bureau of Land and Water Resources

Southport Mall

P.O. Box 10631

Jackson, Mississippi 39209

WATER WELL DRILLERS LOG

HARRISON
H 2122
10/30/80

10/30/80
 date well completed

Lyman Well Co.
 firm name

Harrison
 county well located

LANDOWNER: OJ Rushing
Rt. 2 Box 797
Biloxi, MS
 (mailing address)

description of formations encountered	from	to
<u>Red & yellow clay</u>	<u>0</u>	<u>7</u>
<u>yellow & white sand</u>	<u>7</u>	<u>65</u>
<u>with some gravel</u>		
<u>Blue grey clay</u>	<u>65</u>	<u>270</u>
<u>sand gravel</u>	<u>370</u>	<u>430</u>

WELL LOCATION:
 sec. 26 T-6 N R-10 E
6 miles (distance) of Biloxi (nearest town)

WELL PURPOSE: Home
 (home, irrigation, municipal, industrial)

- WELL COMPLETION DATA:
- (1) diameter (inches) 2"
 - (2) total depth (feet) 430'
 - (3) static water level (feet) 84' below top of ground
 - (4) casing PVC 420'
 (material) (depth)
 - 2" (size) if telescope see back.
 - (5) screen 10' 420'
 (length) (depth to top)
 - 6 slot PVC
 (size) (material)
 - (6) pump 1 12
 (HP) (yield gpm)
 - electric
 (type power)
 - (7) electric log No
 (yes or no)
 - NO
 (organization running log)

(8) how well bottom plugged sand
Shark

DRILLERS REMARKS:


DEPT. OF NATURAL RESOURCES
 BUREAU OF LAND & WATER RESOURCES

FEB 19 1981

RECEIVED

If well telescopes please sketch and show depths.

GROUND LEVEL

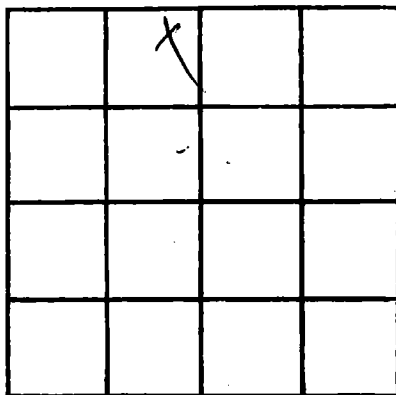

SECTION 26

Please indicate well location X.

ADDITIONAL INFORMATION

If more than one screen, show locations of each on sketch.