

**MISSISSIPPI DEPARTMENT OF NATURAL RESOURCES**  
**Bureau of Land and Water Resources**  
 Southport Mall  
 P.O. Box 10631  
 Jackson, Mississippi 39209  
**WATER WELL DRILLERS LOG**

**HARRISON**  
**H-2123**  
**5-16-81**

May 16 1981 Duncan Well Drilling Harrison  
 date well completed firm name county well located

**LANDOWNER:** Waldo Bartel  
4309 Chamberlain  
Gulfport, Ms 39501  
 (mailing address)

description of formations encountered	from	to
Clay	0	22
Sand	22	56
Blue Clay	56	210
Brown Sand	210	246
Blue Clay	246	400
Line Sand	400	460
Coarse Sand	460	480

**WELL LOCATION:**  
 sec. 27 T-6 N R-10 E  
10 miles N of Blotz  
 (distance) (direction) (nearest town)

**WELL PURPOSE:** Home  
 (home, irrigation, municipal, industrial)

**WELL COMPLETION DATA:**


- (1) diameter (inches) 2"
- (2) total depth (feet) 480 ft
- (3) static water level (feet) 105' below above top of ground.
- (4) casing PVC, 480'  
 (material) (depth)
- (size) If telescope see back.
- (5) screen 10', 470'  
 (length) (depth to top)
- (size) 2", PVC  
 (size) (material)
- (6) pump 1 6  
 (HP) (yield gpm)
- (type power) electric
- (7) electric log \_\_\_\_\_  
 (yes or no)
- (organization running log) \_\_\_\_\_
- (8) how well bottom plugged Sand  
Shark

**DRILLERS REMARKS:** \_\_\_\_\_

DEPT. OF NATURAL RESOURCES  
 BUREAU OF LAND & WATER RESOURCES  
 RECEIVED  
 OCT 19 1981

If well telescopes please sketch and show depths.

GROUND LEVEL

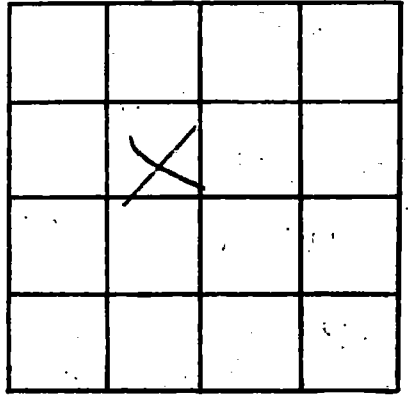

SECTION 27

Please indicate well location X.

ADDITIONAL INFORMATION

If more than one screen, show locations of each on sketch.