

MISSISSIPPI DEPARTMENT OF NATURAL RESOURCES

Bureau of Land and Water Resources

Southport Mall

P.O. Box 10631

Jackson, Mississippi 39209

WATER WELL DRILLERS LOG
COASTAL DRILLING & SERVICE CO.

ROUTE 1 BOX 618

county well located

BILOXI, MISS. 39532

Harrison
H 2124
5-17-81

5/17/81
date well completed

LANDOWNER

Mr. Morris
Loney Bridge Road
Biloxi, Miss
(mailing address)

description of formations encountered

from to

top soil	1	3
Red Clay	3	10
white sand	10	35
Soft Blue Clay	35	115
fine water sand	115	130
1st Blue Clay	130	200
hard Blue Clay	200	240
gravel water sand	240	265

WELL LOCATION:

sec 33 T 6 N R 9 E
Thoutas Bluffs River
(distance) miles (direction) of (nearest town)

WELL PURPOSE:

(home, irrigation, municipal, industrial) *home*


WELL COMPLETION DATA:

- (1) diameter (inches) 2"
- (2) total depth (feet) 265'
- (3) static water level (feet) 40' below above top of ground
- (4) casing PVC 255'
(material) (depth)
- (size) if telescope see back.
- (5) screen 10' 255'
(length) (depth to top)
- 2" PVC
(size) (material)
- (6) pump Ornd 15
(HP) (yield gpm)
- 3hp
(type power)
- (7) electric log no
(yes or no)

(organization running log)

(8) how well bottom plugged

2" back wash valve
DRILLERS REMARKS: 19-13

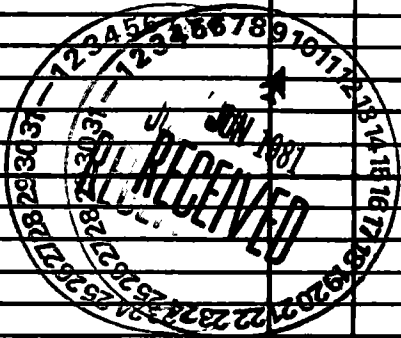

If well telescopes please sketch and show depths.

GROUND LEVEL

			X

SECTION _____

Please indicate well location X.

ADDITIONAL INFORMATION

If more than one screen, show locations of each on sketch.