

MISSISSIPPI DEPARTMENT OF NATURAL RESOURCES

Bureau of Land and Water Resources

Southport Mall

P.O. Box 10631

Jackson, Mississippi 39209

WATER WELL DRILLERS LOG

COASTAL DRILLING & SERVICE CO.

HARRISON  
H 2131

10/25/80  
10/25/80  
date well completed

ROUTE 1 BOX 618

Harrison  
county well located

BILOXI, MISS. 39532

LANDOWNER

John Chestnut  
Woodmarket Lake  
Biledi, Miss  
(mailing address)

description of formations encountered

from to

top soil	1	3
Red Clay	3	18
Coarse white sand	18	45
Super Sand	45	60
Soft Blue Clay	60	210
fresh water sand	210	230
hard Blue Clay	230	295
fine water sand	295	315
Good water sand	315	340

WELL LOCATION:

sec 32 T 6 N R 10 E  
S W  
(1/2) mile N of (distance) (direction) (nearest town)  
Horse Neck Coalville

WELL PURPOSE:

(home, irrigation, municipal, industrial) home

WELL COMPLETION DATA:

- (1) diameter (inches) 2'
- (2) total depth (feet) 340'
- (3) static water level (feet) 20' below top of ground.
- (4) casing PVC, 330' (material) (depth)
- (size) If telescope see back.
- (5) screen 10', 330' (length) (depth to top)
- 2" PVC (size) (material)
- (6) pump one (HP) 15 (yield gpm)
- ele (type power)
- (7) electric log no (yes or no)

(organization running log)

(8) how well bottom plugged  
2 back water valve

DRILLERS REMARKS:


DEPT. OF NATURAL RESOURCES  
BUREAU OF LAND & WATER RESOURCES

MAY 28 1981

RECEIVED

If well telescopes please sketch and show depths.

GROUND LEVEL

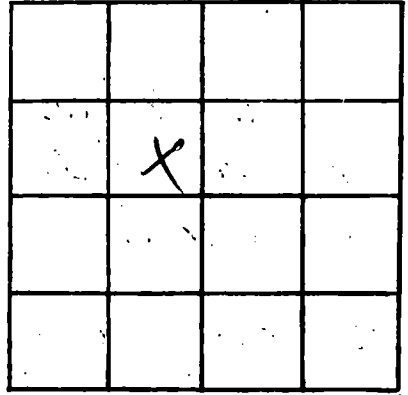

SECTION \_\_\_\_\_

Please indicate well location X.

ADDITIONAL INFORMATION

Lined area for additional information.

If more than one screen, show locations of each on sketch.