

MISSISSIPPI DEPARTMENT OF NATURAL RESOURCES

Bureau of Land and Water Resources

Southport Mall

P.O. Box 10631

Jackson, Mississippi 39209

WATER WELL DRILLERS LOG

HARRISON
H 2139
6-10-81

COASTAL DRILLING & SERVICE CO. *Harrison*

6/10/81 19
date well completed

ROUTE 1 BOX 618
county well located

LANDOWNER: *Larry Wade*
Rt 5
Biloxi, Miss
(mailing address)

encountered	from	to
<i>top soil</i>	<i>1</i>	<i>3</i>
<i>Red Clay</i>	<i>3</i>	<i>25</i>
<i>fine white sand</i>	<i>25</i>	<i>60</i>
<i>Soft Blue Clay</i>	<i>60</i>	<i>165</i>
<i>Water sand</i>	<i>165</i>	<i>185</i>
<i>Gravel with sand</i>	<i>185</i>	<i>210</i>

WELL LOCATION:
sec *23 T 6 N R 10 E*
3 1/2 miles *North* *Clare*
(distance) (direction) (nearest town)

WELL PURPOSE: *Home*
(home, irrigation, municipal, industrial)


WELL COMPLETION DATA:

- (1) diameter (inches) *2"*
- (2) total depth (feet) *210'*
- (3) static water level (feet) *70'* below top of ground
- (4) casing *Pvc 200"* (material) (depth)
- (5) screen *10'* (length) *200'* (depth to top)
2" (size) *Pvc* (material)
- (6) pump *Drasill* (HP) *10* (yield gpm)
3/4 (type power)
- (7) electric log *SW* (yes or no)

(organization running log)

(8) how well bottom plugged
2" backwash drilled

DRILLERS REMARKS: *19-B*

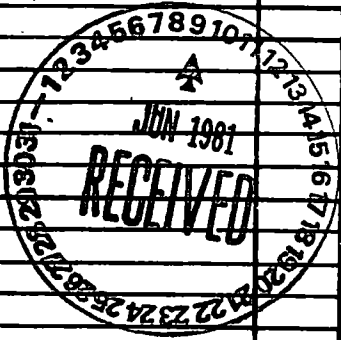

If well telescopes please sketch and show depths.


GROUND LEVEL

		10/10/10	10/10/10
			10/10/10
			10/10/10
		X	10/10/10

SECTION _____

Please indicate well location X.

ADDITIONAL INFORMATION

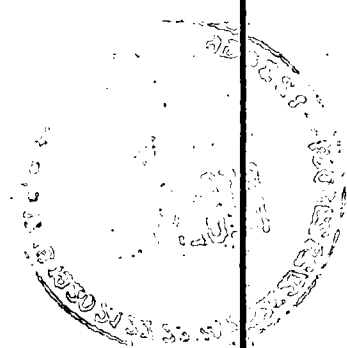

If more than one screen, show locations of each on sketch.