

HARRISON
H 2140

MISSISSIPPI
BOARD OF WATER COMMISSIONERS
416 North State Street
Jackson, Mississippi 39201

2/1/81

WATER WELL DRILLERS LOG

Braden Pump +
1981 Well Ser Inc.

HARRISON
county well located

date well completed

firm name

LANDOWNER:
FRANK COUNTRY MAN
MAISON DORLEANS Apts
Biloxi, MS
(mailing address)

description of formations encountered	from	to
Clay	0	20
Sand	20	110
Blue clay	110	500
Sand	500	518
Clay	518	540
Sand	540	580

WELL LOCATION:
sec. 33 T. 6 N R. 10 E
S W
1 miles N of Woodmark +
(distance) (direction) (nearest town)

WELL PURPOSE: home
(home, irrigation, municipal, industrial)

WELL COMPLETION DATA:
(1) diameter (inches) 4 1/2
(2) total depth (feet) 580
(3) static water level (feet) 70 below top of ground.
(4) casing PVC, total 4 1/2 (material), (depth), (size) If telescope see back.
(5) screen 10' 570 (length), (depth to top) 2" PVC, (size), (material)
(6) pump 1 (HP) 15 (yield gpm) 230 (type power)
(7) electric log no (yes or no)
(organization running log)

(8) how well bottom plugged
2" sand SHARK

DRILLERS REMARKS:
no tail pipe


DEPT. OF NATURAL RESOURCES
BUREAU OF LAND & WATER RESOURCES

MAY 19 1981

RECEIVED

If well telescopes please sketch and show depths.

GROUND LEVEL

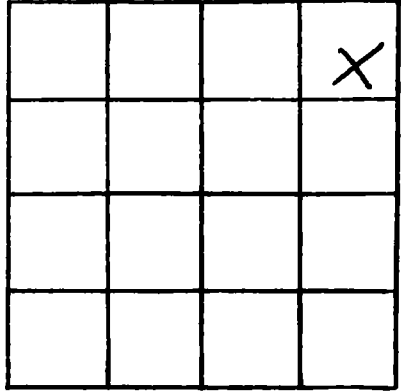

SECTION 33

Please indicate well location X.

ADDITIONAL INFORMATION

If more than one screen,
show locations of each on sketch.