

MISSISSIPPI DEPARTMENT OF NATURAL RESOURCES

Bureau of Land and Water Resources

Southport Mall

P.O. Box 10631

Jackson, Mississippi 39209

WATER WELL DRILLERS LOG

COASTAL DRILLING & SERVICE CO.

HARRISON
H 2141
7/21/81

date well completed 7/21/81 19 ROUTE 1 BOX 618 Harrison
firm name county well located

BILOXI, MISS. 39532

LANDOWNER Carl Hanson
RT I
Biloxi Min
(mailing address)

description of formations encountered	from	to
<u>top soil</u>	<u>1</u>	<u>3</u>
<u>red clay</u>	<u>3</u>	<u>15</u>
<u>gray sand</u>	<u>15</u>	<u>60</u>
<u>blue white sand</u>	<u>60</u>	<u>170</u>
<u>soft blue clay</u>	<u>170</u>	<u>230</u>
<u>fine water sand</u>	<u>230</u>	<u>250</u>
<u>soft blue clay</u>	<u>250</u>	<u>310</u>
<u>hard blue clay</u>	<u>310</u>	<u>460</u>
<u>fine water sand</u>	<u>460</u>	<u>500</u>
<u>good water sand</u>	<u>500</u>	<u>530</u>

WELL LOCATION:
sec 34 T 6N R 10E
S W
Walden
(distance) miles (direction) of (nearest town)

WELL PURPOSE: home
(home, irrigation, municipal, industrial)

WELL COMPLETION DATA:

(1) diameter (inches) 2"

(2) total depth (feet) 530'


(3) static water level (feet) 70' below above top of ground.

(4) casing PVC, 520' (material), (depth)
(size) If telescope see back.

(5) screen 10", 520' (length), (depth to top)
2", PVC (size), (material)

(6) pump One 11, 10 (HP), (yield gpm)
Electric (type power)

(7) electric log no (yes or no)
(organization running log)

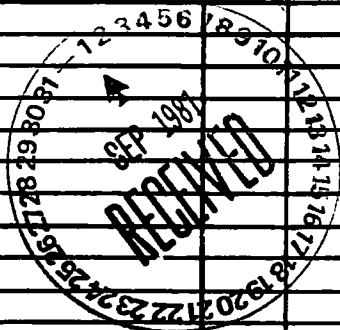

(8) how well bottom plugged
2" hard water table
DRILLERS REMARKS: 19-B

If well telescopes please sketch and show depths.

GROUND LEVEL

X			

SECTION _____

Please indicate well location X.

ADDITIONAL INFORMATION

If more than one screen, show locations of each on sketch.