




If well telescopes please sketch and show depths.

GROUND LEVEL

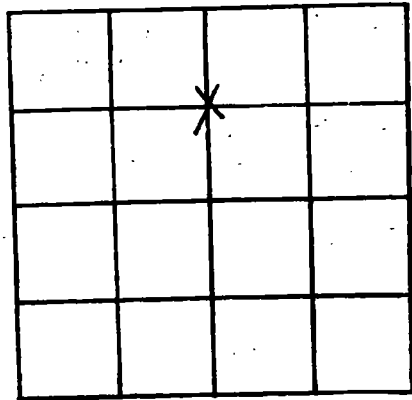


SECTION 35

Please indicate well location X.

ADDITIONAL INFORMATION

Horizontal lines for additional information.

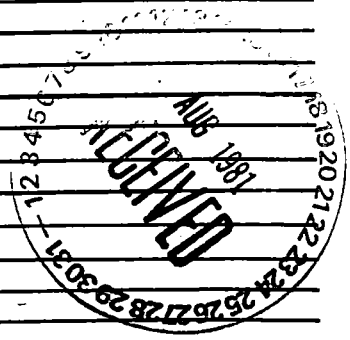

If more than one screen, show locations of each on sketch.