

MISSISSIPPI DEPARTMENT OF NATURAL RESOURCES

Bureau of Land and Water Resources

Southport Mall

P.O. Box 10631

Jackson, Mississippi 39209

WATER WELL DRILLERS LOG
COASTAL DRILLING & SERVICE CO.

ROUTE 1 BOX 618

firm name
BILOXI, MISS. 39532

county well located

HARRISON
H 2144
8/24/81

date well completed

19

Harrison

LANDOWNER: W. Ross
Old Walnut Road
Biloxi, Miss
(mailing address)

description of formations encountered

from

to

Top Soil	1	3
Pit Clay	3	15
White Sand	15	60
Soft Blue Clay	60	210
hard Blue Clay	210	270
fine white sand	270	285
grit water sand	285	305

WELL LOCATION:
sec. 29 T. 6 N. R. 10 E.
S. W.
Mississippi Power line
(distance) (direction) (nearest town)

WELL PURPOSE: home
(home, irrigation, municipal, industrial)

WELL COMPLETION DATA:

(1) diameter (inches) 2"

(2) total depth (feet) 305'

(3) static water level (feet) 60' below above top of ground.


(4) casing PVC 295'
(material) (depth)
(size) if telescope see back.

(5) screen 10' 295'
(length) (depth to top)
2" PVC
(size) (material)

(6) pump Oneil 12
(HP) (yield gpm)
5hp
(type power)

(7) electric log no
(yes or no)


(organization running log)

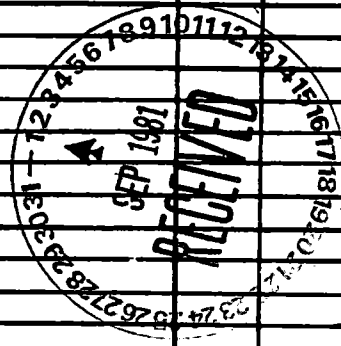

(8) how well bottom plugged
2' red water table
DRILLERS REMARKS: 19-B

If well telescopes please sketch and show depths.

GROUND LEVEL

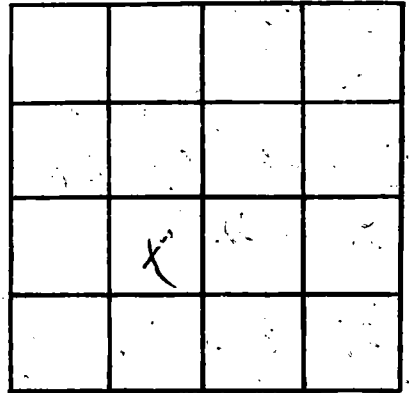

SECTION _____

Please indicate well location X.

ADDITIONAL INFORMATION

If more than one screen, show locations of each on sketch.