

MISSISSIPPI DEPARTMENT OF NATURAL RESOURCES

Bureau of Land and Water Resources

Southport Mall

P.O. Box 10631

Jackson, Mississippi 39209

WATER WELL DRILLERS LOG

HARRISON
H 2145
5-20-81

May 20 1981 Harrison Well Drilling Harrison  
 date well completed firm name county well located

LANDOWNER: Michael Ward  
Rt. 5 Box 684-S  
Gulfport, Ms. 39503  
 (mailing address)

description of formations encountered	from	to
<u>Clay Sand</u>	<u>0</u>	<u>40</u>
	<u>40</u>	<u>75</u>

WELL LOCATION:  
 sec. 31 T. 6 N. R. 10 E.  
5 miles E of Rugent  
 (distance) (direction) (nearest town)

WELL PURPOSE: home  
 (home, irrigation, municipal, industrial)

WELL COMPLETION DATA:

- (1) diameter (inches) 2"
- (2) total depth (feet) 75 ft.
- (3) static water level (feet) 20' below top of ground.
- (4) casing PVC, 75'  
 (material) (depth)
- (5) screen 10', 65'  
 (length) (depth to top)  
2"  
 (size) (material)
- (6) pump 1, 10  
 (HP) (yield gpm)  
electric  
 (type power)
- (7) electric log                       
 (yes or no)  
 (organization running log)
- (8) how well bottom plugged hard


DRILLERS REMARKS:                     

DEPT. OF NATURAL RESOURCES  
 BUREAU OF LAND & WATER RESOURCES

OCT 19 1981  
 RECEIVED

If well telescopes please sketch and show depths.

GROUND LEVEL

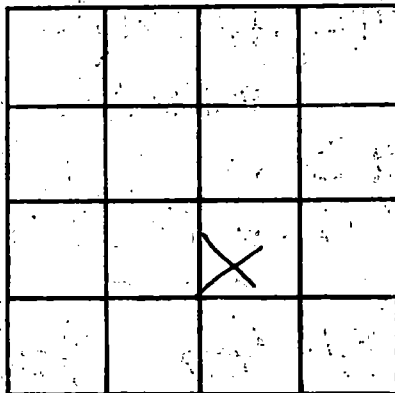

SECTION 31

Please indicate well location X.

ADDITIONAL INFORMATION

If more than one screen, show locations of each on sketch.