

MISSISSIPPI DEPARTMENT OF NATURAL RESOURCES

Bureau of Land and Water Resources

Southport Mall

P.O. Box 10631

Jackson, Mississippi 39209

WATER WELL DRILLERS LOG

HARRISON
H 2047
6-17-81

June 17 1981 Duncan Well Drilling Harrison
 date well completed firm name county well located

LANDOWNER: Gene Wattman
Lorraine Road
Woolmarket Ms.
 (mailing address)

description of formations encountered	from	to
Clay	0	15
Sand	15	50
White Clay	50	105
Blue Clay	105	390
Green Sand	390	440
Coarse Sand	440	463

WELL LOCATION:
 sec 34 T 6 N R 10 E
2 miles E of Woolmarket
 (distance) (direction) (nearest town)

WELL PURPOSE: Home
 (home, irrigation, municipal, industrial)

WELL COMPLETION DATA:

(1) diameter (inches) 4" x 2"

(2) total depth (feet) 463' 290-4"

(3) static water level (feet) 105' below above top of ground.

(4) casing PVC, 463'
 (material) (depth)

10' If telescope see back.
 (size)

(5) screen 10', 453'
 (length) (depth to top)

2", PVC
 (size) (material)

(6) pump _____ (HP) _____ (yield gpm)

_____ (type power)

(7) electric log _____ (yes or no)

_____ (organization running log)


(8) how well bottom plugged Sand

DRILLERS REMARKS: Owner installed his own pump

DEPT. OF NATURAL RESOURCES
 BUREAU OF LAND & WATER RESOURCES
 RECEIVED
 OCT 19 1981

If well telescopes please sketch and show depths.

GROUND LEVEL

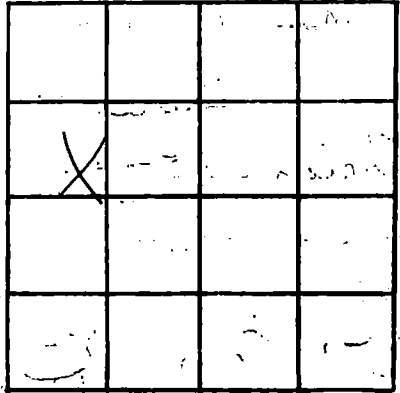

SECTION 34

Please indicate well location X.

ADDITIONAL INFORMATION

If more than one screen, show locations of each on sketch.