

MISSISSIPPI DEPARTMENT OF NATURAL RESOURCES

Bureau of Land and Water Resources

Southport Mall

P.O. Box 10631

Jackson, Mississippi 39209

WATER WELL DRILLERS LOG

HARRISON
H 2648
9-28-81

Sept. 28 1981 Duncan Well Drilling Harrison
date well completed firm name county well located

LANDOWNER: Margaret Lee
439 Benachi Ave.
Biloxi, Ms.
(mailing address)

description of formations encountered	from	to
clay	0	10
sand	10	43
white clay	43	111
blue clay	111	225
brown sand	225	260
blue clay	260	380
fine sand	380	400
coarse sand	400	441

WELL LOCATION:
sec 18 T 6 N R 10 E
3 miles N. of Woodmark
(distance) (direction) (nearest town)

WELL PURPOSE: Home
(home, irrigation, municipal, industrial)

WELL COMPLETION DATA:


- (1) diameter (inches) 2"
- (2) total depth (feet) 441 ft.
- (3) static water level (feet) 80' below top of ground.
- (4) casing PVC 431'
(material) (depth)
- (5) screen 10' 431'
(length) (depth to top)
2" PVC
(size) (material)
- (6) pump 1 10
(HP) (yield gpm)
electric
(type power)
- (7) electric log (yes or no) _____
- (organization running log) _____
- (8) how well bottom plugged hard
shark

DRILLERS REMARKS: _____

DEPT. OF LAND AND WATER RESOURCES
RECEIVED
OCT 19 1981

If well telescopes please sketch and show depths.

GROUND LEVEL

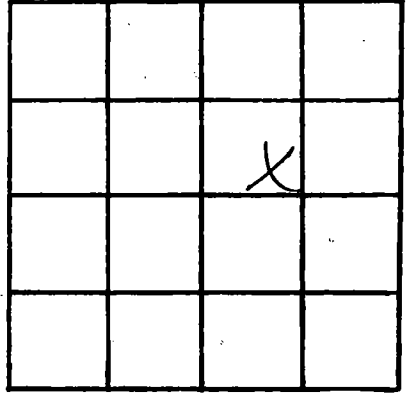

SECTION 18

Please indicate well location X.

ADDITIONAL INFORMATION

If more than one screen, show locations of each on sketch.