

MISSISSIPPI DEPARTMENT OF NATURAL RESOURCES

Bureau of Land and Water Resources

Southport Mall

P.O. Box 10631

Jackson, Mississippi 39209

WATER WELL DRILLERS LOG

HARRISON
H 2149
8-6-81

8-6-81
date well completed

19 Lyman Well Co.
firm name

Harrison
county well located

LANDOWNERS Dale Hodge,
Rt 6, Box 8200
Belzoni, Md
(mailing address)

description of formations encountered	from	to
Red sandy clay gravel	0	60
gray clay	60	-150
Blue gray clay	150	230
fine sand	230	258
Blue Clay	258	331
good sand	331	380

WELL LOCATION:

sec. 28 T 6 N R 10 E
1 1/2 miles N/E of Lockhart
(distance) (direction) (nearest town)

WELL PURPOSE: home
(home, irrigation, municipal, industrial)

WELL COMPLETION DATA:

- (1) diameter (inches) 2"
- (2) total depth (feet) 380'
- (3) static water level (feet) 80' below top of ground.
- (4) casing PVC 370' (material) (depth)
2" (size) If telescope see back.
- (5) screen 10' 370' (length) (depth to top)
2" PVC (size) (material)
- (6) pump 1 10 (HP) (yield gpm)
electric (type power)
- (7) electric log No (yes or no)
No (organization running log)
- (8) how well bottom plugged sand sea


RECEIVED
 OCT 13 10:37 AM '81

DRILLERS REMARKS:

DEPT. OF NATURAL RESOURCES
BUREAU OF LAND & WATER RESOURCES
OCT 20 1981
RECEIVED

If well telescopes please sketch and show depths.

GROUND LEVEL

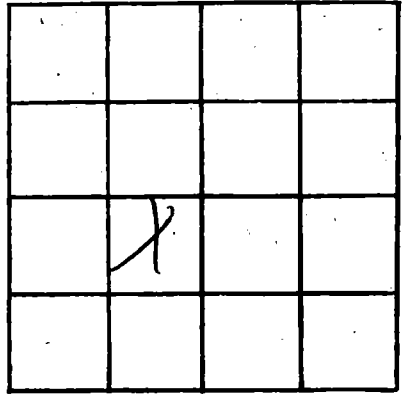

SECTION 28

Please indicate well location X.

ADDITIONAL INFORMATION

If more than one screen, show locations of each on sketch.