

MISSISSIPPI DEPARTMENT OF NATURAL RESOURCES

Bureau of Land and Water Resources

Southport Mall

P.O. Box 10631

Jackson, Mississippi 39209

WATER WELL DRILLERS LOG

HARRISON
H 2150
9-13-81

y

this would be low Guffport

9/13/81
 date/well completed

Lyman Well
 firm name

Harrison
 county well located

LANDOWNER: Warren Howard
Rt 9 Box 106
Gulfport Ms
 (mailing address)

description of formations encountered	from	to
White Sand	0	40
Sand Grey Clay	40	65
Salt pm Sand	65	110

WELL LOCATION:
 sec. 22 T. 76 N. R. 11 E.
9 miles N/E of Port
 (distance) (direction) (nearest town)

WELL PURPOSE: home
 (home, irrigation, municipal, industrial)

WELL COMPLETION DATA:

- (1) diameter (inches) 2"
- (2) total depth (feet) 110
- (3) static water level (feet) 6 below above top of ground.
- (4) casing PVC 100
 (material) (depth)
2"
 (size) If telescope see back.
- (5) screen 10' 100
 (length) (depth to top)
2" PVC
 (size) (material)
- (6) pump N/A 15
 (MP) (yield gpm)
Electric
 (type power)
- (7) electric log N/A
 (yes or/no)

(organization running log)

(8) how well bottom plugged Sand Slark


DRILLERS REMARKS:

DEPT. OF NATURAL RESOURCES
 BUREAU OF LAND & WATER RESOURCES

OCT 20 1981
RECEIVED

If well telescopes please sketch and show depths.

GROUND LEVEL

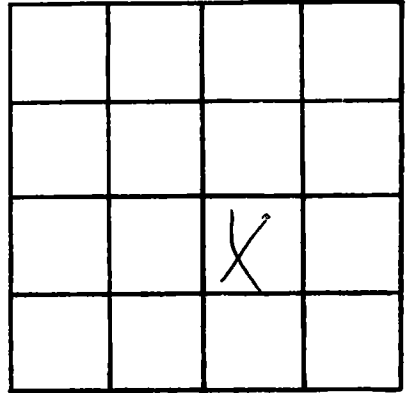

SECTION 22

Please indicate well location X.

ADDITIONAL INFORMATION

If more than one screen,
show locations of each on sketch.