

MISSISSIPPI DEPARTMENT OF NATURAL RESOURCES

Bureau of Land and Water Resources

Southport Mall

P.O. Box 10631

Jackson, Mississippi 39209

WATER WELL DRILLERS LOG

HARRISON  
H 2157  
9-19-81

9/19/81 19 Lyman Well Co. Davis  
date well completed firm name county well located

LANDOWNER: Nitchells Auto Salvage  
Rt. 1, Box 7720  
N. Biloxi, Md 39530  
 (mailing address)

description of formations encountered

from	to
0	7
7	60

WELL LOCATION:

sec 8 T 6 N R 10 E  
3 1/2 miles N/E of Dowl Market  
 (distance) (direction) (nearest town)

WELL PURPOSE: Home  
 (home, irrigation, municipal, industrial)

WELL COMPLETION DATA:

- (1) diameter (inches) 2"
- (2) total depth (feet) 20
- (3) static water level (feet) 29 below top of ground
- (4) casing PVC 50  
 (material) (depth)  
2" If telescope see back.  
 (size)
- (5) screen 10" 50  
 (length) (depth to top)  
2" PVC  
 (size) (material)
- (6) pump 1 12  
 (HP) (yield gpm)  
Electric  
 (type power)
- (7) electric log NO  
 (yes or no)

(organization running log)

(8) how well bottom plugged Seal  
check

DRILLERS REMARKS:


DEPT. OF NATURAL RESOURCES  
 BUREAU OF LAND & WATER RESOURCES

OCT 20 1981

RECEIVED

If well telescopes please sketch and show depths.

GROUND LEVEL

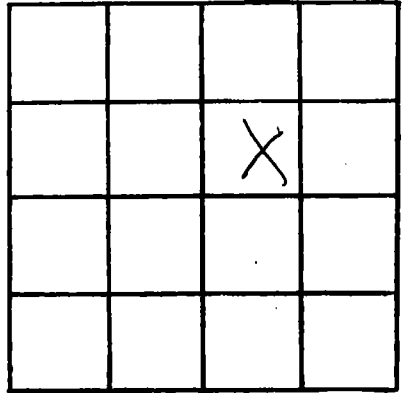

SECTION 8

Please indicate well location X.

ADDITIONAL INFORMATION

If more than one screen, show locations of each on sketch.