

MISSISSIPPI DEPARTMENT OF NATURAL RESOURCES

Bureau of Land and Water Resources

Southport Mall

P.O. Box 10631

Jackson, Mississippi 39209

COASTAL WATER WELL DRILLERS LOG & SERVICE CO.

ROUTE 1 BOX 618

BILOXI, MISS. 39532

county well located

H
2153

9/1/81
date well completed

Harrison
county well located

LANDOWNER: A. J. Jentura
Rt 3 Box 15
Biloxi, Miss
(mailing address)

description of formations encountered	from	to
Top Soil	1	3
Red Clay	3	20
Grey Sand	20	35
White Sand	35	60
Soft Blue Clay	60	230
Hard Blue Clay	230	290
Grey Water Sand	290	310
Good Water Sand	310	325

WELL LOCATION:
sec 32 T 6 N R 9 E
S W
Gas Pipeline
(distance) (direction) (nearest town)

WELL PURPOSE: Industrial
(home, irrigation, municipal, industrial)

WELL COMPLETION DATA:
(1) diameter (inches) 2"
(2) total depth (feet) 325'
(3) static water level (feet) 40' below top of ground.
(4) casing PVC 315'
(material) (depth)
(size) If telescope see back.
(5) screen 10' 315'
(length) (depth to top)
2" PVC
(size) (material)
(6) pump one 1/2 12 gpm
(HP) (yield gpm)
9 hp
(type power)
(7) electric log no
(yes or no)
(organization running log)

(8) has well bottom plugged
2" sand seal
DRILLERS REMARKS: Sand Seal


DEPT. OF NATURAL RESOURCES
BUREAU OF LAND & WATER RESOURCES

JAN 15 1982

RECEIVED

If well telescopes please sketch and show depths.

GROUND LEVEL

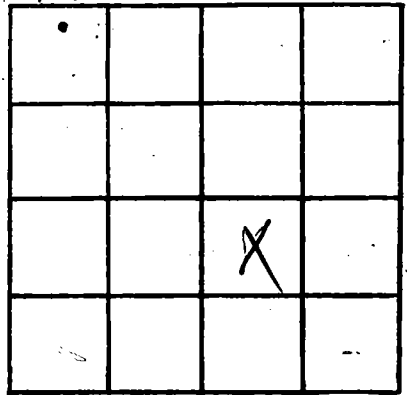

SECTION _____

Please indicate well location X.

ADDITIONAL INFORMATION

If more than one screen,
show locations of each on sketch.